

WATER SERVICE RECORD

#6450

Name Tarabelli Bros, Inc.

Service No. 81

Address 24 Partridge Road

Location Lot #70 Sta 16-91

~~RWXXXKROBYAK~~ - New Service W.O. #8128

Comm 2-10-64


Date	Material	Amount	Total	Date	Material	Amount
8/31/61	Labor	3 78		9-21-63	Deposit	200 00
	10% O.H.	38	4 16	2-10-64	Retard	99 99
	12' 3/4" Copper tubing @ .42		5 04			102 03
	1 Hr. Trucking @ 3.00		3 00			
	BILL WHEN CONNECTED		12 20	8/31/61	Labor	3 15
10/8/63	Labor	13 13		10'	3/4" copper tubing @ .42	4 20
	10% O.H.	1 31	14 44	1	3/4" C Corp Cock	4 91
	120' 3/4" Copper Tubing @ .42		50 40	1	3/4" C Curb Cock	6 28
	1 3/4" Cx 1/2 I.W.H. Stop & Waste		6 17	1	Box & Rod	4 90
	2 3/4" C3 Part Unions @ 2.41		4 82			23 44
	1 Hr. Town Truck @ 3.00		3 00	10/9/63	Labor	28 91
	11 X 3 Patch		11 00		14 3/4" Copper Tubing @ .42	5 88
			102 03		1 3/4" C Curb Cock	6 28
					1 3/4" C Corp Cock	4 91
					1 Box & Rod	4 90
					1 1/2 Straight Tailpiece	50
					1 1/2 Offset Tailpiece	50
					1 Hr. Town Shovel @ 6.50	6 50
						58 35

DATE _____

TOWN OF LEXINGTON — BOARD OF PUBLIC WORKS

WATER DIVISION

Sketch of Service Here

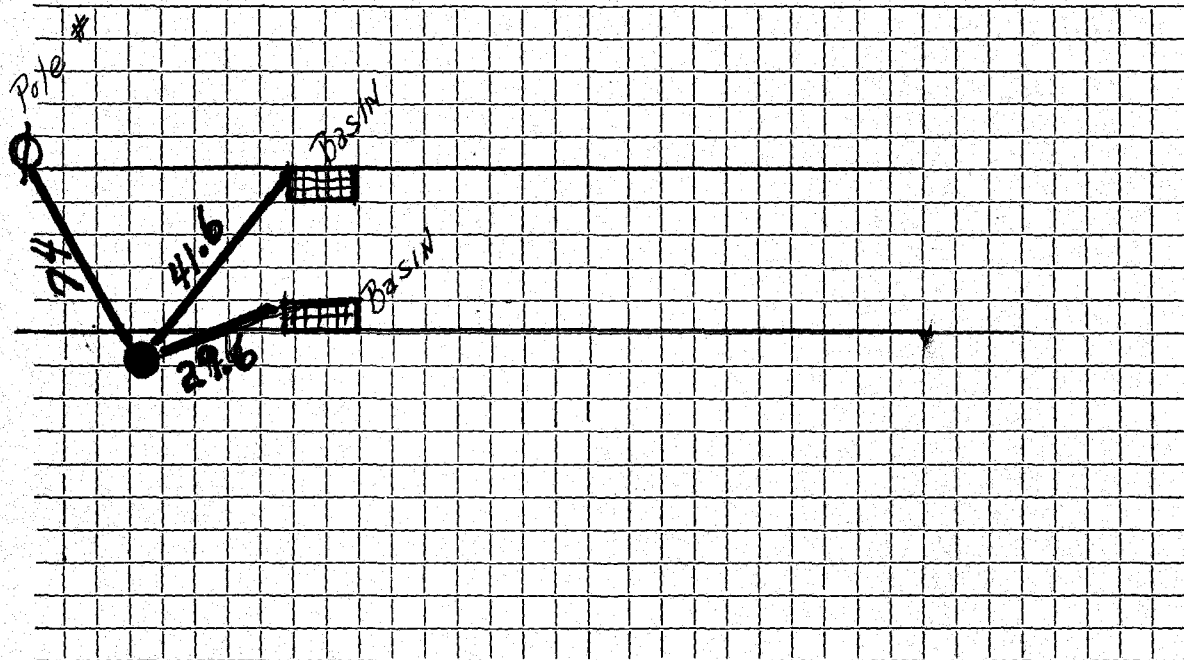

Connection made in Street. Work completed

Remarks:

.....
.....