




DATE 7-5-01

TOWN OF LEXINGTON — BOARD OF PUBLIC WORKS

WATER DIVISION

Sketch of Service Here

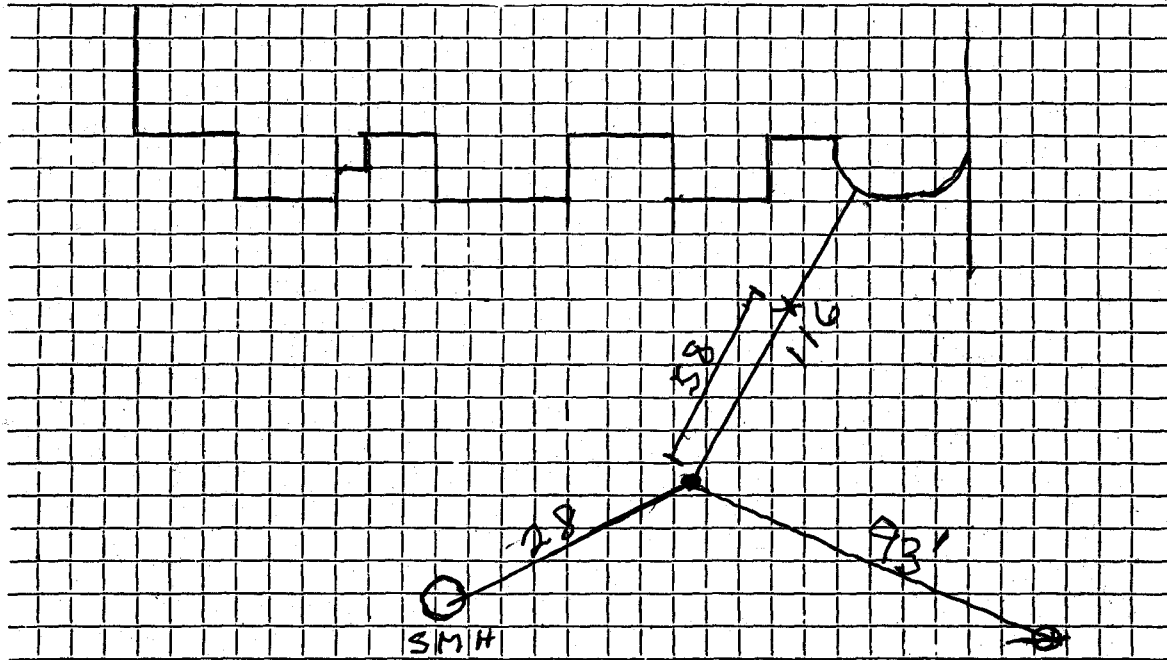

Connection made in PARTRIDGE RD Street. Work completed 14 7-5-01

Remarks: WORK DONE BY ACCURAT PAVING INC