

WATER SERVICE RECORD

Name Holiday Homes Inc.

Service No. #65

Address 29 Partridge Road

Location Lot #78 Sta 21/12

~~Replaced~~ New Service

WO # 7331


Comm 7-16-62

Date	Material	Amount	Total	Date		Amount
6-5-62	Labor	4.26		5-29-62	Deposit	25.00
	10% O.H.	.43	4.69	7-16-62	Refund	18.83
95'	3/4" Copper tubing @.42		39.90			56.17
1	3/4" Cx 1/2 I/W.H. Stop & Waste		6.17			
1	3/4" C3 Part Union		2.41	8/5/61	Labor	8.19
1	Hr. Trucking @3.00		3.00	26'	3/4" Copper tubing @.42	10.92
			56.17	1	3/4" C Corp Cock	4.91
				1	3/4" C Curb Cock	6.28
				1	Box & Rod	4.90
						35.20
				6/5/62	1 1/2" Straight Tailpiece	50
					1 1/2" Offset Tailpiece	50
						36.20

TOWN OF LEXINGTON — BOARD OF PUBLIC WORKS

WATER DIVISION

Sketch of Service Here

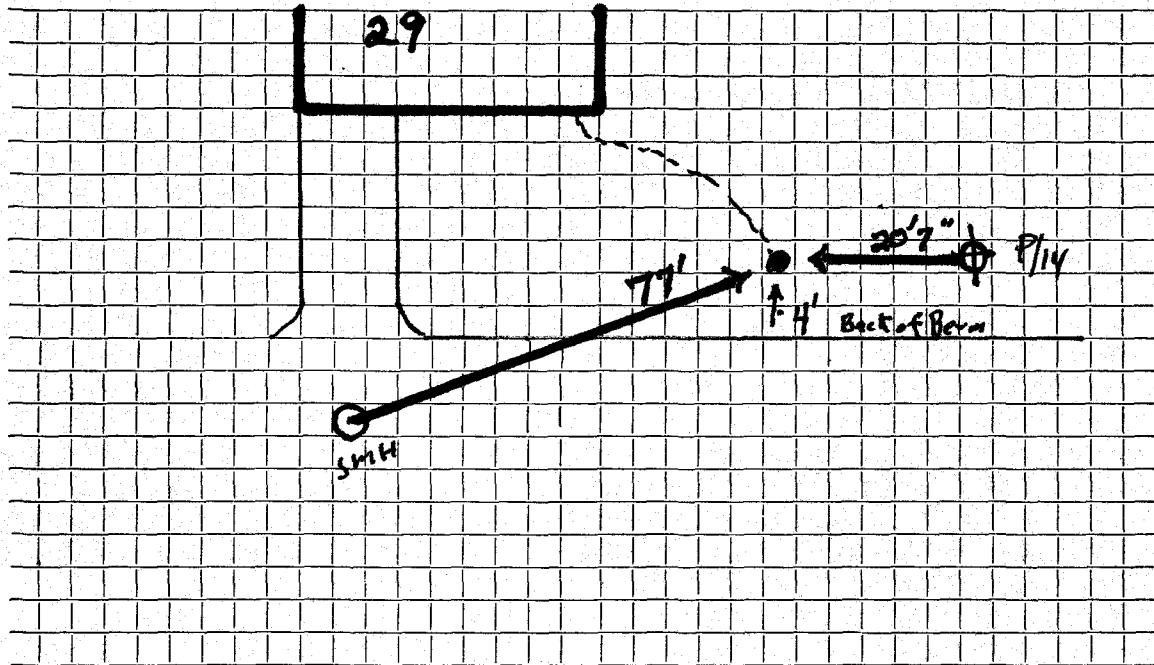

Connection made in Street. Work completed

Remarks:
.....
.....