

## WATER SERVICE RECORD

Name Holiday Homes Inc.

# 3456

Service No. 151

Address 30 Partridge Road (Mail: P.O. Box 221 Wayland, Mass.)

Location Lot #73 Sta 21/24

~~REPAIRS~~ New Service


Comm 12-4-61

Date	Material	Amount	Total	Date	Amount	
8/2/61	Labor	4 10		10-4-61	Deposit	75 00
	10% O.H.	41	4 51	12-4-61	Paid by WHC #141	2 03
13'	3/4" Copper tubing @.42		5 46			77 03
1	Hr. Trucking @3.00		3 00			
	BILL WHEN CONNECTED		12 97	8/2/61	Labor	3 78
10/13/61	Labor	11 54		12'	3/4" Copper tubing @.42	5 04
	10% O.H.	1 15	12 69	1	3/4" C Corp Cock	4 91
89'	3/4" Copper Tubing @ .42		37 38	1	3/4" C Curb Cock	6 28
1	3/4" Cx 1/2 IWH Stop & Waste		6 17	1	Box & Rod	4 90
2	3/4" C3 part Unions @2.41		4 82			24 91
1	Hr. Trucking @ 3.00		3 00	1 1/2	Straight Tailpiece	50
			77 03	1 1/2	Offset Tailpiece	50
						25 91

TOWN OF LEXINGTON — BOARD OF PUBLIC WORKS

**WATER DIVISION**

Sketch of Service Here

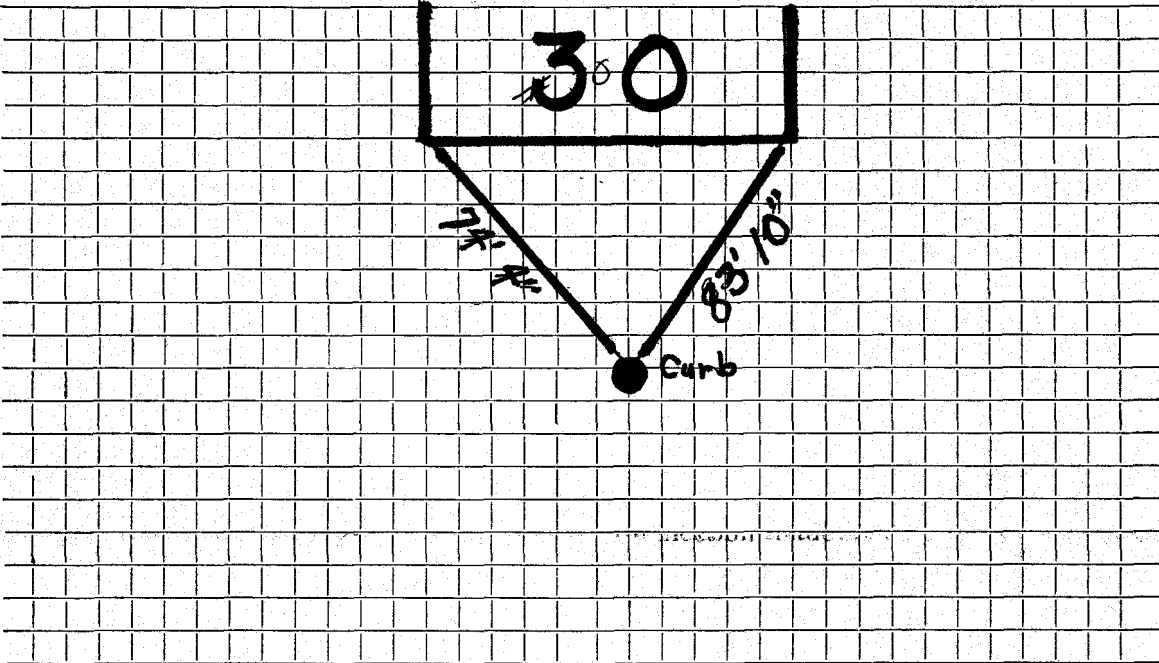

Connection made in ..... Street. Work completed .....

Remarks: .....  
.....  
.....