

WATER SERVICE RECORD

Name Holiday Homes, Inc.Service No. 141Address 31 Partridge RoadLocation Lot #77 Sta 22/66~~Renewal~~ New Service

Comm. 12-1-61


Date	Material	Amount	Total	Date		Amount
9/30/61	Labor	1360		9-27-61	Deposit	25 00
	10% O.H.	136	14 96	12-4-61	* Resund	12 34
86'	3/4" Copper Tubing @ .42		36 12			62 66
1	3/4" C 3 Part Union	2.41	2 41			
1	3/4" Cx 1/2 IWH Stop & Waste		6 17	8/2/61	Labor	8 51
1	Hr. Trucking @ 3.00		3 00		27' 3/4" Copper tubing @ .42	11 34
			62 66		1 3/4" C Corp Cock	4 91
					1 3/4" C Curb Cock	6 28
					1 Box & Rod	4 90
						35 94
					1 1/2 Straight Tailpiece .50	50
					1 1/2 Offset Tailpiece .50	50
						36 94
					* Apply 2.03 to WH C# 151	
					* " 10.31 to WH C# 97	

DATE _____

TOWN OF LEXINGTON — BOARD OF PUBLIC WORKS

WATER DIVISION

Sketch of Service Here

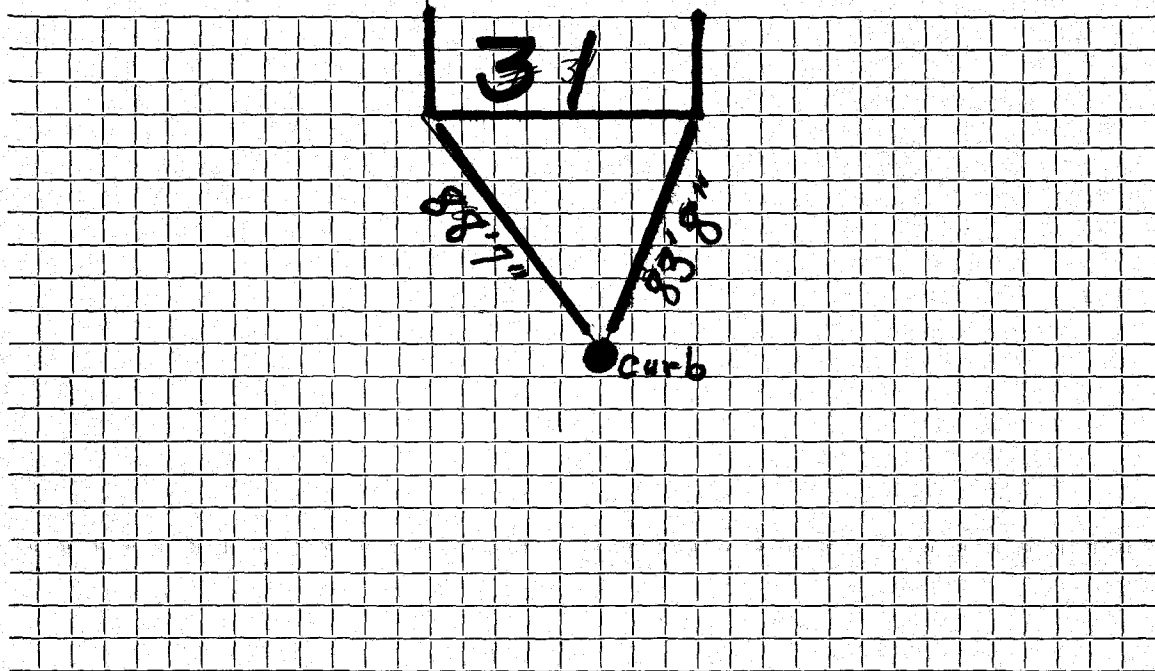

Connection made in Street. Work completed

Remarks:
.....
.....