

## WATER SERVICE RECORD

# 817  
#

Name Tricorn Homes, Inc.

Service No. 143

Address 33 Partridge Road (184 Bedford St.,)

Location Lot #76 Sta 24/17

~~Renewal~~ - New Service


Comm 12-4-61

Date	Material	Amount	Total	Date		Amount
9/30/61	Labor	14 96		9-28-61	Deposit	25 00
	10% O.H.	1 50	16 46	12-4-61	Refund	10 00
	88' 3/4" Copper Tubing @ .42		36 96			65 00
	1 3/4" Cx 1/2 IWH Stop & Waste		6 17			
	1 3/4" C3 Part Union	2 41	2 41	8/5/61	Labor	6 93
	1 Hr. Trucking @ 3.00		3 00		22' 3/4" Copper tubing @ .42	9 24
			65 00		1 3/4" C Corp Cock	4 91
					1 3/4" C Curb Cock	6 28
					1 Box & Rod	4 90
						32 26
					1 1/2" Straight Tailpiece	50
					1 1/2" Offset Tailpiece	50
						33 26

TOWN OF LEXINGTON — BOARD OF PUBLIC WORKS

**WATER DIVISION**

Sketch of Service Here

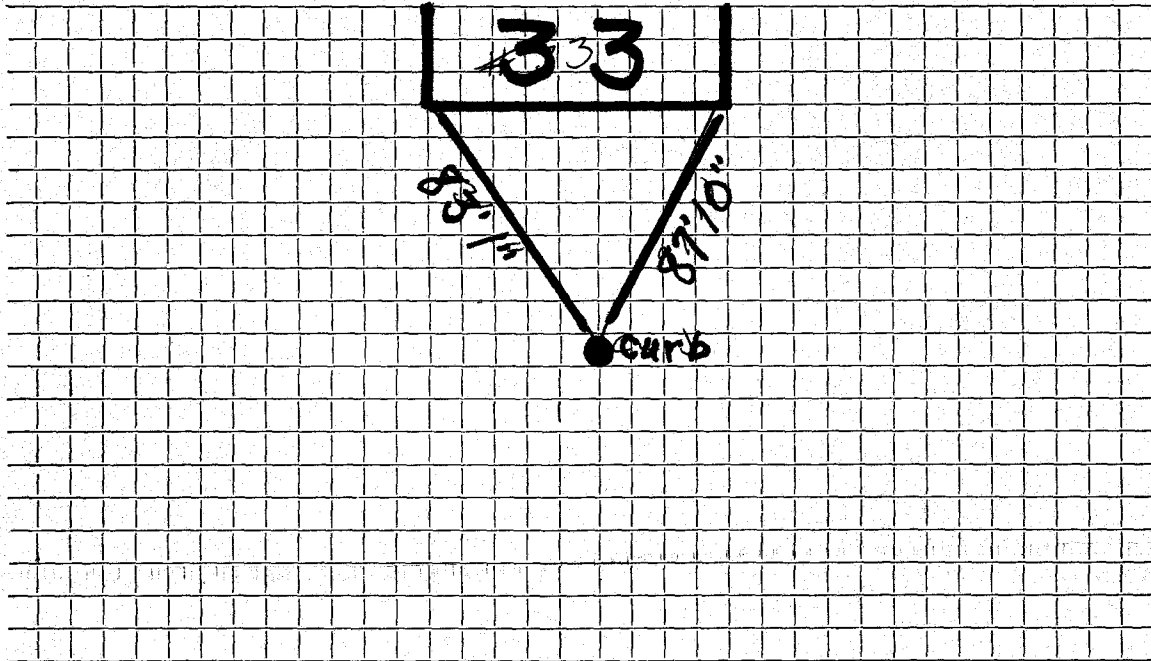

Connection made in ..... Street. Work completed .....

Remarks: .....  
.....  
.....