

WATER SERVICE RECORD

#2353

Name Holiday Homes, Inc.

Service No. #27

Address 5 Partridge Road

Location Lot #90 Sta 3/20

~~Repair~~ New Service WO #7141

Comm 6-25-62


Date	Material	Amount	Total	Date		Amount
4-17-62	Labor	10.46		4-12-62	Deposit	65.07
	10% O.H.	1.05	11.51	4-25-62	Returned	12.93
69'	3/4" Copper tubing @.42		28.98			52.07
1	3/4" Cx 1/2" I.W.H. Stop & Waste		6.17			
1	3/4" C3 Part Union		2.41	7/28/61	Labor	8.51
1	Hr. Trucking @3.00		3.00	27'	3/4" Copper tubing @.42	11.34
			52.07	1	3/4" C Corp Cock	4.91
				1	3/4" C Curb Cock	6.28
	(Owner dug trench			1	Box & Rod	4.90
	Service was in to curb)					35.94
				4/17/62	1 1/2 Straight tailpiece	.50
					1 1/2 Offset Tailpiece	.50
						36.94

* Applied to WHC #34

TOWN OF LEXINGTON — BOARD OF PUBLIC WORKS

WATER DIVISION

Sketch of Service Here

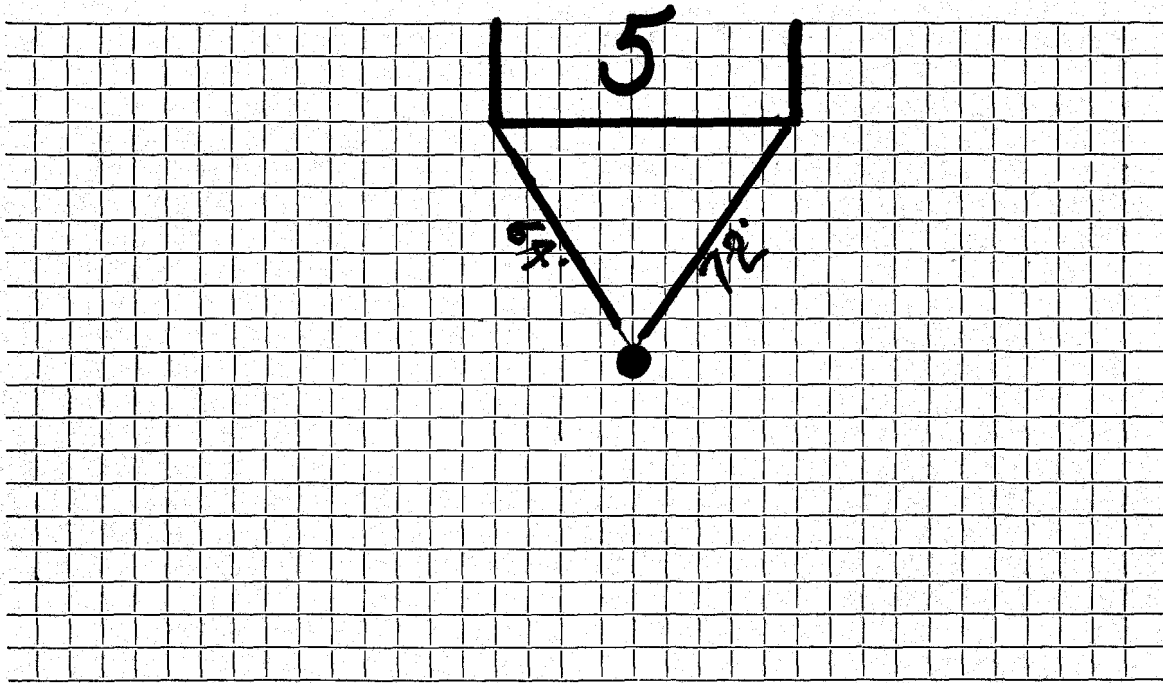

Connection made in Street. Work completed

Remarks:
.....
.....