

### WATER SERVICE RECORD

Name **Holiday Homes, Inc.**

Service No. **185**

Address **6 Partridge Road**

# 1756

Location **Lot #62 Sta 4 4/3**

~~WATER SERVICE~~ **New Service**

Comm 12-31-61

Date	Material	Amount	Total	Date	Material	Amount
7/28/61	Labor	4 10		11-21-61	Deposit	80 00
	10% O.H.	41	4 51	12-31-61	Retained	1 24
	13' 3/4" Copper tubing @ .42		5 46			78 76
	1 Hr. Trucking @ 3.00		3 00			
	BILL WHEN CONNECTED		12 97	7/28/61	Labor	3 15
11/30/61	Labor	7 76			10' 3/4" Copper tub. @ .42	4 20
	10% O.H.	78	8 54		1 3/4" C Corp Cock	4 91
	103' 3/4" Copper Tubing @ .42		43 26		1 3/4" C Curb Cock	6 28
	1 3/4" C x 1/2 IWH Stop & Waste		6 17		1 Box & Rod	4 90
	2 3/4" C3 Part Unions @ 2.41		4 82			23 44
	1 Hrs. Trucking @ 3.00		3 00	11/30/61	1 1/2 Straight Tailpiece	50
	PREVIOUS CHARGE		12 97		1 1/2 Offset Tailpiece	50
			78 76			24 44


Applied to utility # 341

DATE \_\_\_\_\_

# TOWN OF LEXINGTON — BOARD OF PUBLIC WORKS

## WATER DIVISION

Sketch of Service Here

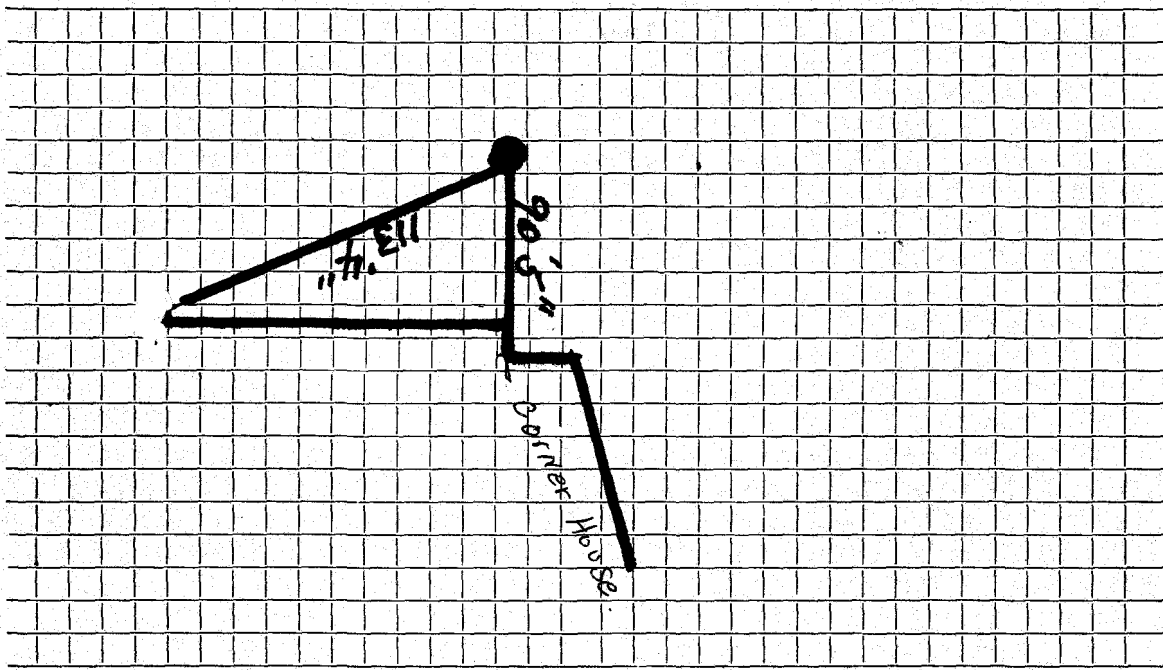

Connection made in ..... Street. Work completed .....

Remarks: .....  
.....  
.....