



DATE \_\_\_\_\_

TOWN OF LEXINGTON — BOARD OF PUBLIC WORKS

**WATER DIVISION**

Sketch of Service Here

A large grid of 20 rows and 20 columns, intended for sketching service details. The grid is currently blank.

Connection made in ..... Street. Work completed .....

Remarks: See Card 9 Patricia TERR for curb location

.....  
.....




DATE \_\_\_\_\_

TOWN OF LEXINGTON — BOARD OF PUBLIC WORKS

WATER DIVISION

Sketch of Service Here

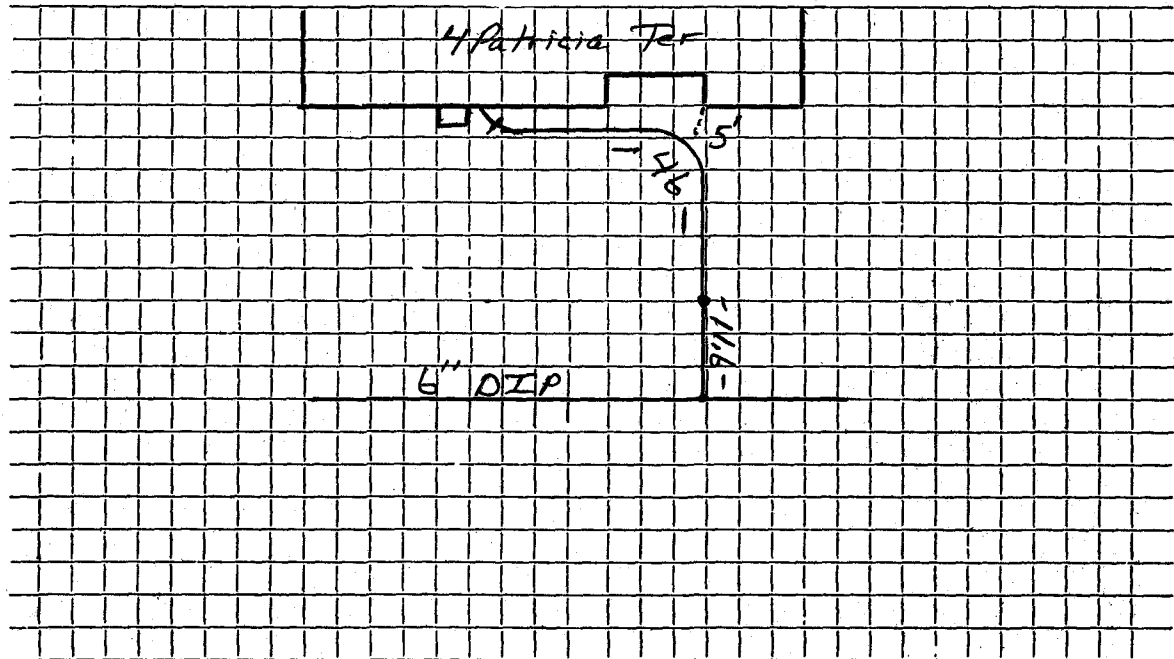

Connection made in ..... Street. Work completed 7-30-02

Remarks: 1 X 3/4 3 part union 1.8" From Foundation