




TOWN OF LEXINGTON — BOARD OF PUBLIC WORKS

WATER DIVISION

Sketch of Service Here

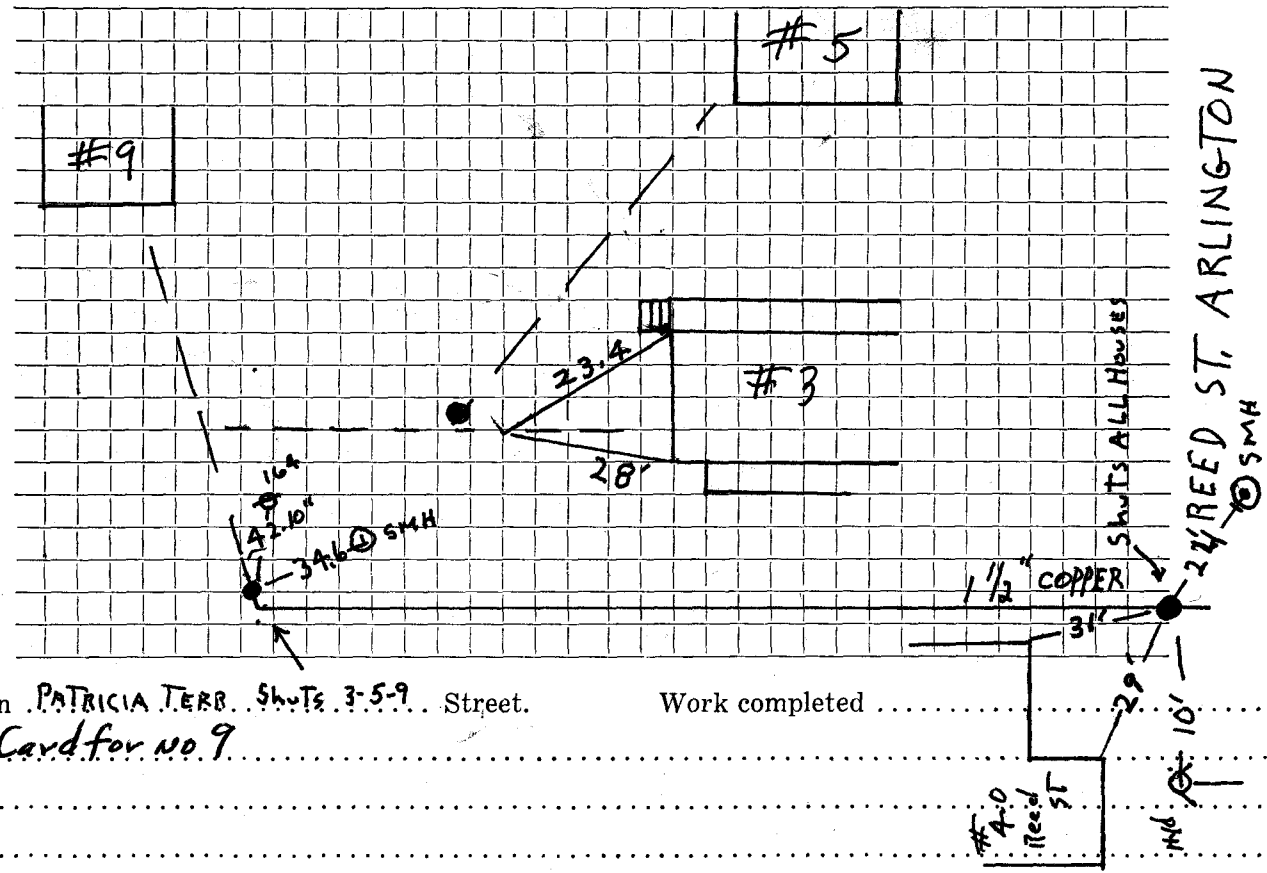

Connection made in PATRICIA TERR. SHOTS 3-5-9 Street.

Work completed .....

Remarks: See Card for no. 9

#4-0  
Rec'd  
ST

10'

SMH

SHOTS ALL HOUSES