

WATER SERVICE RECORD

Name **Henry M. Sanger**

Service No.

Address **9 Patricia Terrace**


Location **Lexington, Mass.**

~~Repair/Replacement~~ — **New Service**

Date	Material	Amount	Total	Date	Amount
					<u>NON CHARGE</u>
	TRENCH DUG BY OWNER			1 - $\frac{1}{2}$	offset tail piece 50
	PIPE SUPPLIED AND LAID BY OWNER			1 - $\frac{1}{2}$	straight tail piece 50
					1 00
	NO CHARGE - ALL WORK DONE BY OWNER				

TOWN OF LEXINGTON — BOARD OF PUBLIC WORKS
WATER DIVISION

Sketch of Service Here

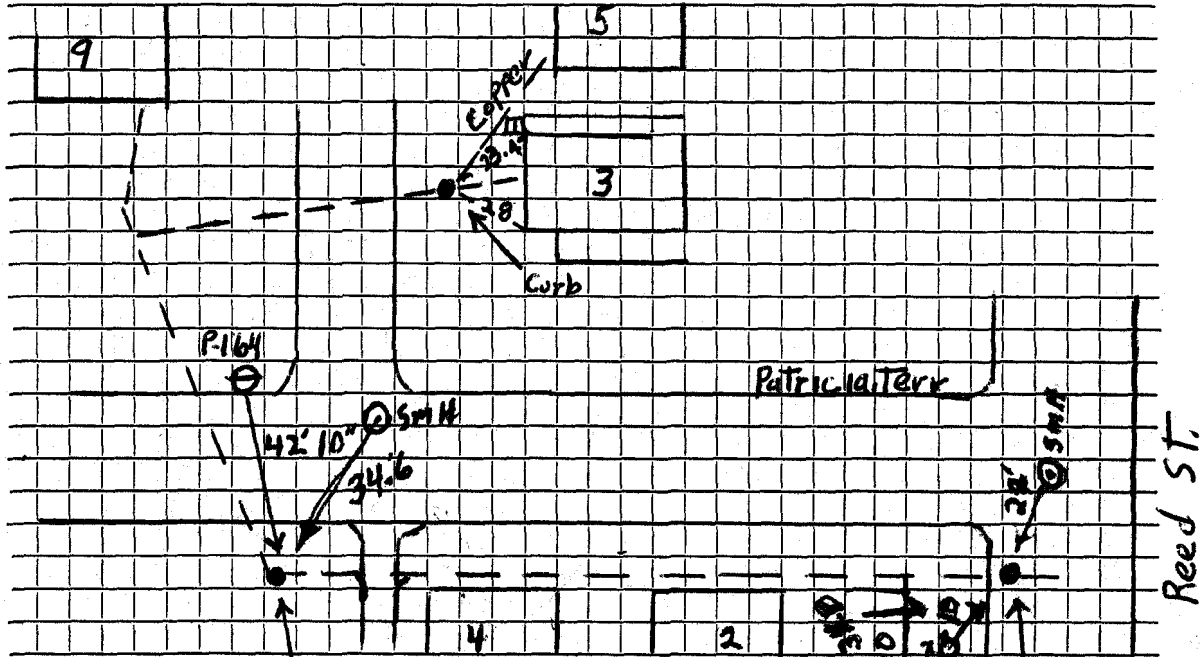

Connection made in Curb for - 3-5-9 Street. Work completed 1 1/2" Copper


Remarks: _____

DATE _____

TOWN OF LEXINGTON — BOARD OF PUBLIC WORKS

WATER DIVISION

Sketch of Service Here

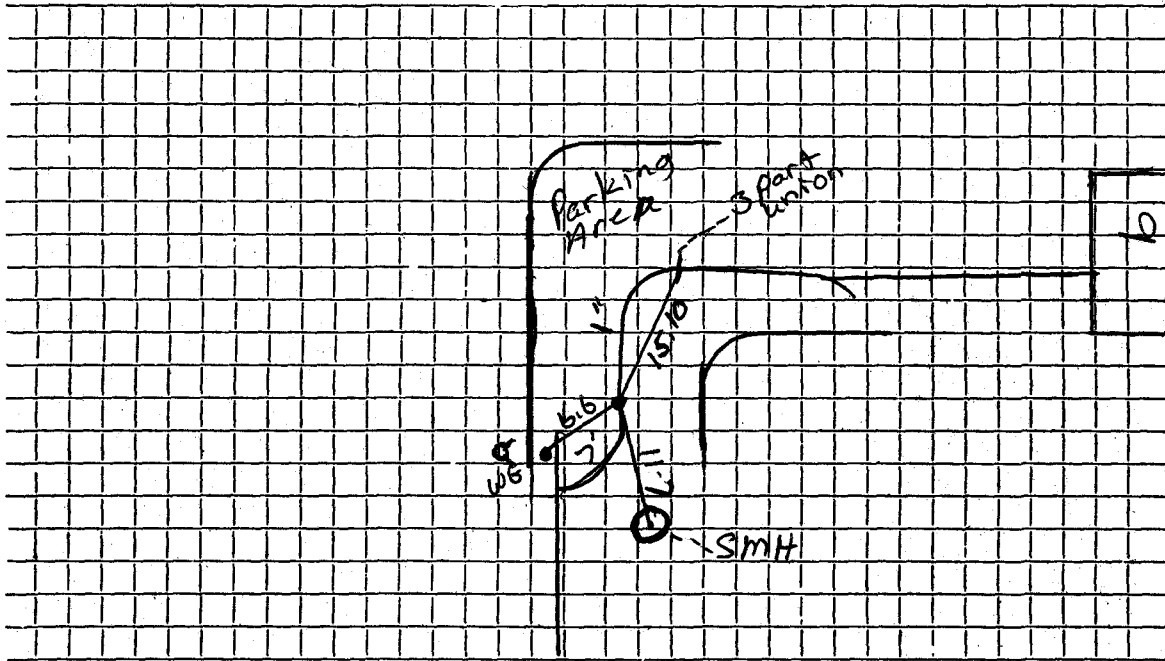

Connection made in Street. Work completed

Remarks:

.....

.....