


DATE July 2001

TOWN OF LEXINGTON — BOARD OF PUBLIC WORKS

WATER DIVISION

Sketch of Service Here

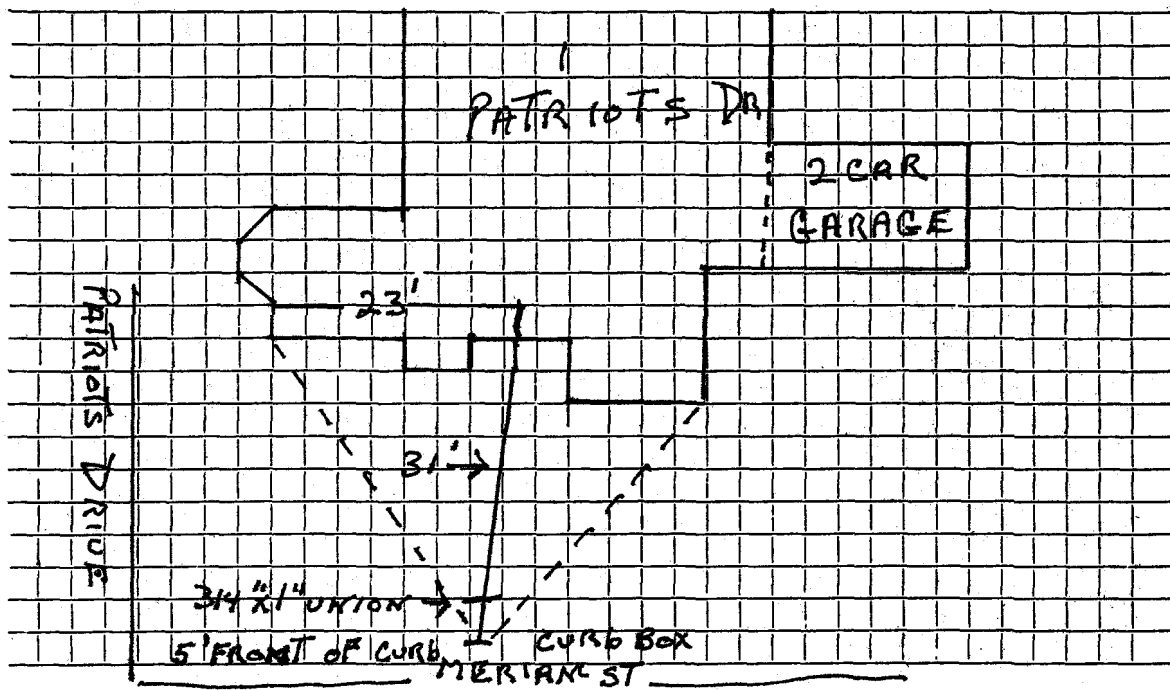

Connection made in MERIAM ST..... Street. Work completed

Remarks: INSTALLED BY J.M. McLAUGHLIN, INC......