

Name Harvey Newgent

Service No. *#3348*

Address 11 Patriots Drive

Lexington, Mass.

Location 11 Patriots

Kind of Pipe Com. May 31, 1948

Size

Size of Main

~~REPAIRS~~ - New Service

Location

Date	Material	Amount	Total	Date	Amount
Mar. 11, '48	Labor	2 10	2 10	Jan. 5 '48	40 00
	10% Overhead		21	June 3 '48	8 96
	87' - 3/4" Copper Tubing @.255	22 19			31 04
	1 - 3/4"C x 1/2" I.W.H. S & W		3 15	Mar. 11, '48	2 10
	2 - 3/4"C x 3/4"C Union (3pts.)	2 64		14' - 3/4"Copper Tubing @.255	3 57
	Trucking 1 hr. @.75		75	1 - 3/4" C Corp-cock	3 00
			31 04	1 - 3/4"C x 3/4" C Curb-cock	3 68
				1 - Box & Rod	3 50
				Trucking 1 hr. @.75	75
				1 - 1/2" Offset Tail Piece	30
				1 - 1/2" Straight Tail Piece	50
					<u>17 20</u>
	Labor				

TOWN OF LEXINGTON - BOARD OF PUBLIC WORKS

WATER DIVISION

The undersigned applies for a supply of water at No..... St. and hereby agrees to comply with the rules and regulations as now, or at any future time, established by the Board of Selectmen.

Am't of Estimate \$.....

Owner


Am't Paid \$.....

Address

Builder

.....

Sketch of Service Here

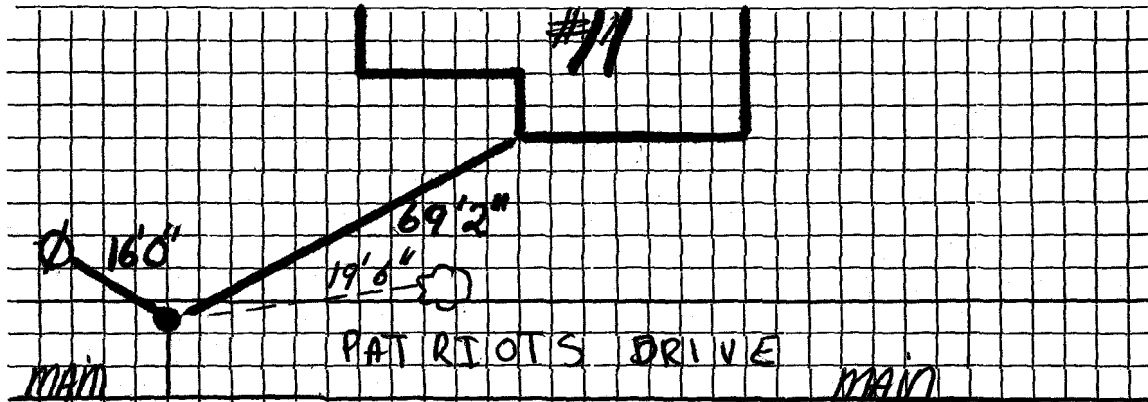

Connection made in Street.

Work completed19

Remarks :