


TOWN OF LEXINGTON — BOARD OF PUBLIC WORKS

WATER DIVISION

Sketch of Service Here

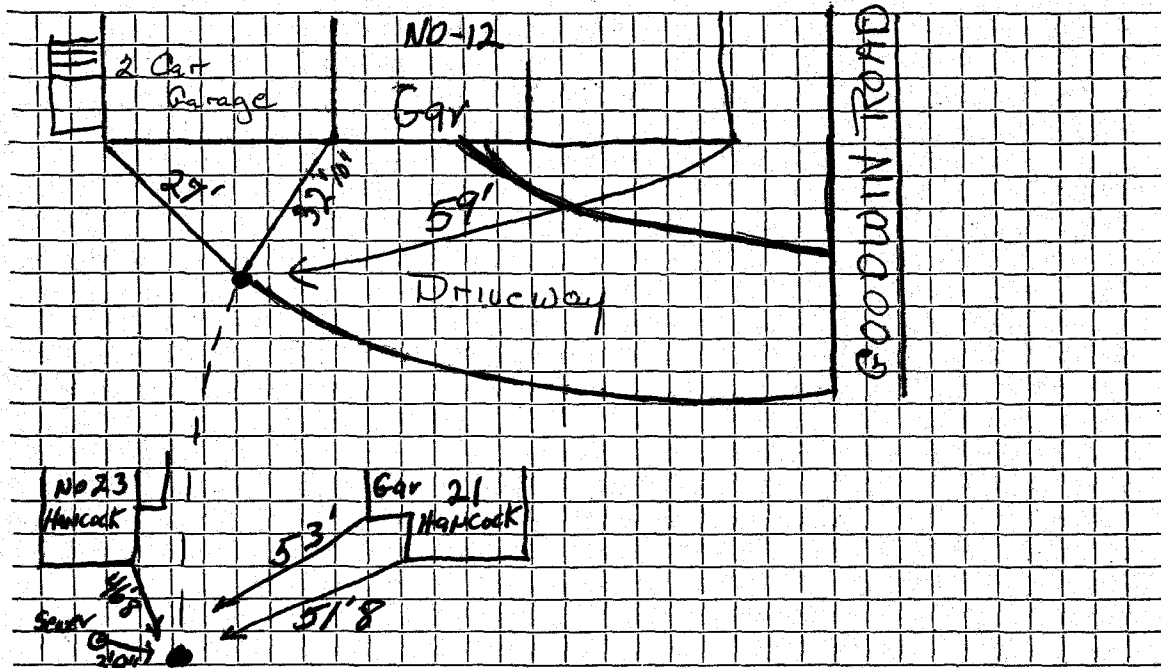

Connection made in HARCOCK ST. Street. Work completed

Remarks: W95. 15 Goodwin Rd. This shut off Kills 12 Patriots Dr & 17 Goodwin Rd