




DATE \_\_\_\_\_

# TOWN OF LEXINGTON — BOARD OF PUBLIC WORKS

## WATER DIVISION

Sketch of Service Here

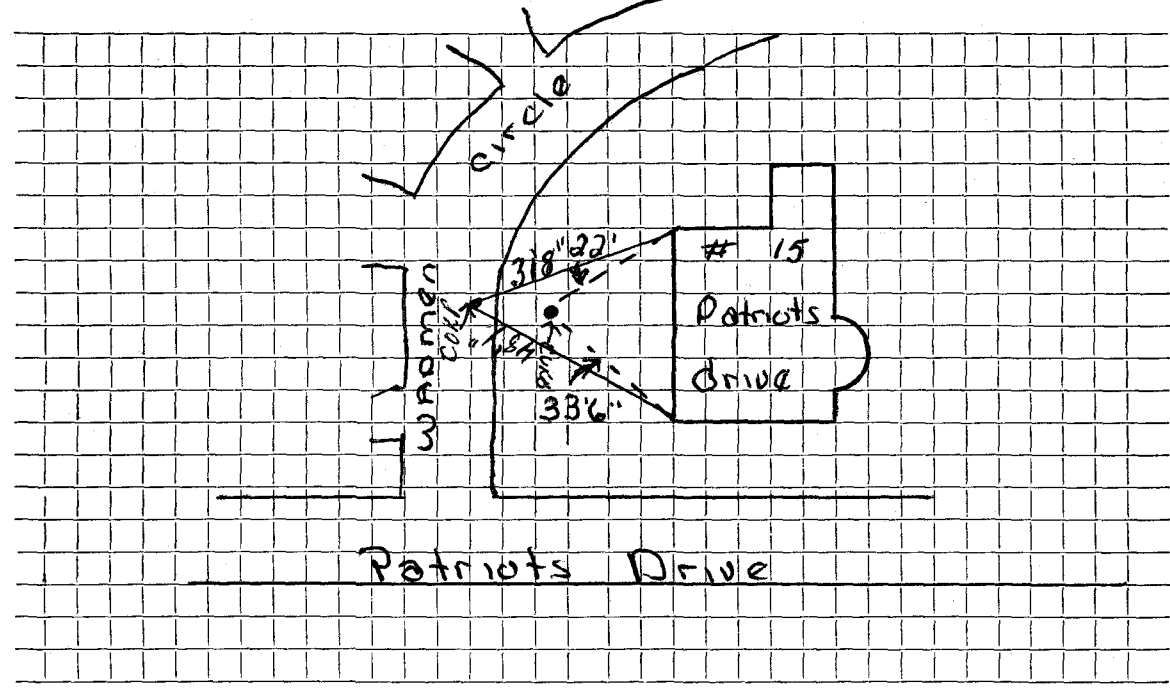

Connection made in ..... Street. Work completed .....

Remarks: .....  
15' 7" OUTSIDE 1" CORNER .....  
19' 5" INSIDE 1" CORNER .....