

WATER SERVICE RECORD

Name Lillian Pickering

Service No. 22

Address 3 Patriots Drive

Location Lexington, Mass.


~~Repair/Repair~~ New Service Com. 5-21-51

Date	Material	Amount	Total	Date	Amount
3-14-51	Labor	2 70	2 70	May 5 '57	25 00
	10% Overhead		27	June 30 '51	13 35
	63' - 1" Copper Tubing @ .43		27 09		38 35
	1 - 1"C x 1" I.W.H. S&W		5 12		
	1 - 1"C x 1"C Union (3pts)		1 83		
	1 - 1" x 3/4" Bushing		59		
	Trucking 1 hr. @ .75		75		
			38 35		
	<i>Bill sent 6-13-51</i>				

DATE _____

TOWN OF LEXINGTON — BOARD OF PUBLIC WORKS
WATER DIVISION

Sketch of Service Here

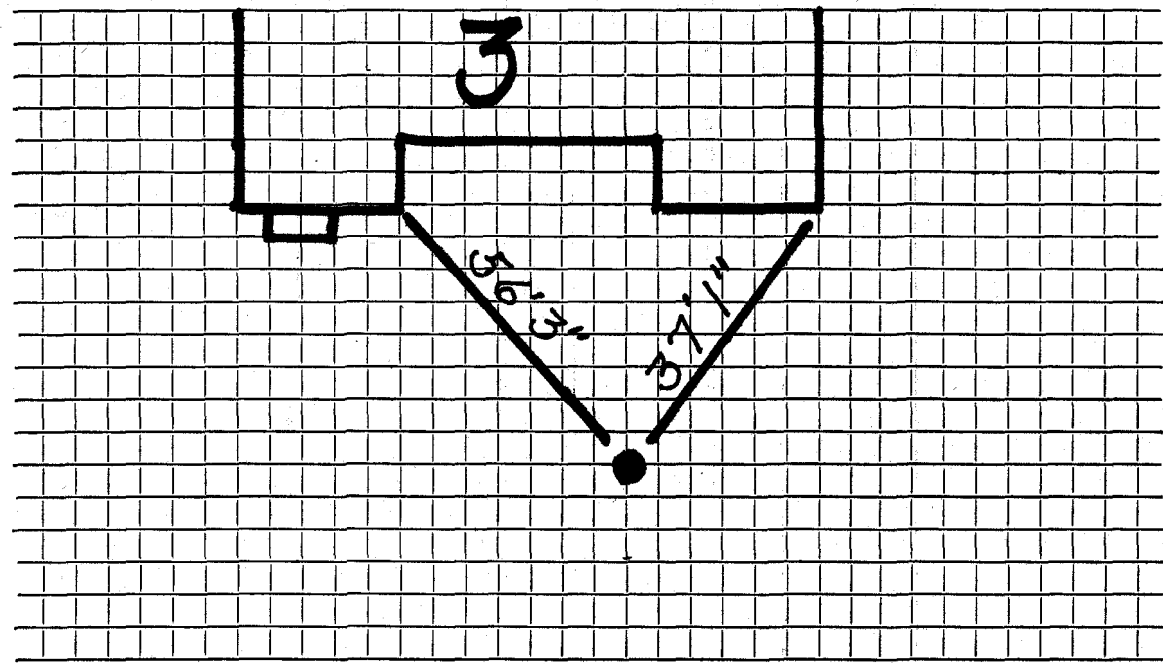

Connection made in Street. Work completed

Remarks: Original Service 6-26-48

.....
.....