

Name Robert Merriam

Service No. ~~30~~ 2180

Address 4 Oakmount Circle
6 Patriots Drive

#6232

Location #6 Patriot's Drive

Kind of Pipe

Size

Size of Main

~~Repair~~ ~~Renewal~~ ~~New Service~~

Location

Date

Material

Amount

Total

Date

Amount

Service installed
by owner, with permission
of Town.

Labor

TOWN OF LEXINGTON—BOARD OF PUBLIC WORKS

WATER DIVISION

The undersigned applies for a supply of water at No. 6 Patriot's Drive St. and hereby agrees to comply with the rules and regulations as now, or at any future time, established by the Board of Selectmen.

Am't. of Estimate \$ _____

Owner

Robert C. Furman

Am't. Paid \$ _____


Address

4 Patriot's Drive

Builder Walter G. Black

Lex

Sketch of Service Here

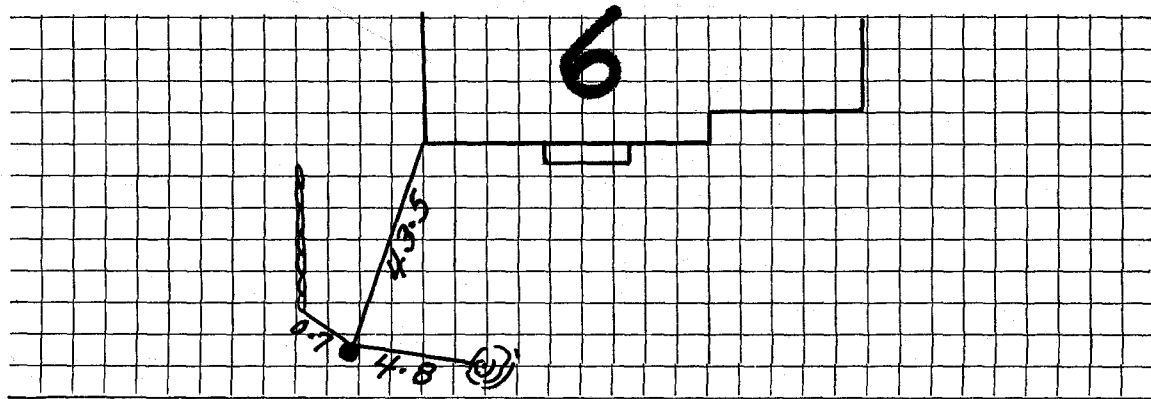

Connection made in _____ Street.

Work completed _____ 19

Remarks: