

Name Carl D. Hall, Contractor (Owner Lois Marshall)

Service No. **2182**

Address 199 Park Ave., Arlington Heights
7 Patriots Drive

Location **7 Patriots Drive**

Kind of Pipe _____ Size _____ Size of Main _____

~~Repair-Renewal~~—New Service

Location _____

Date
1940

Material

Amount

Total

Date

Amount

Jan. 12,

3 1/2 hrs. @ 60¢

2 10

January 16, 1940 Paid

14 15

Com 1-22-40

1/2 hr. @ 65¢

33

2 43

10% Overhead

24

41' 1" Copper tubing @ 13¢

7 38

1 1" x 3/4" S. & W.

2 10

Trucking and Gravel

2 00

14 15

Labor

Hadley Press, Inc., Lexington

DATE _____

TOWN OF LEXINGTON—BOARD OF PUBLIC WORKS

WATER DIVISION

The undersigned applies for a supply of water at No. _____ St. and hereby agrees to comply with the rules and regulations as now, or at any future time, established by the Board of Selectmen.

Am't. of Estimate \$ _____


Owner _____

Am't. Paid \$ _____

Address _____

Builder _____

Sketch of Service Here

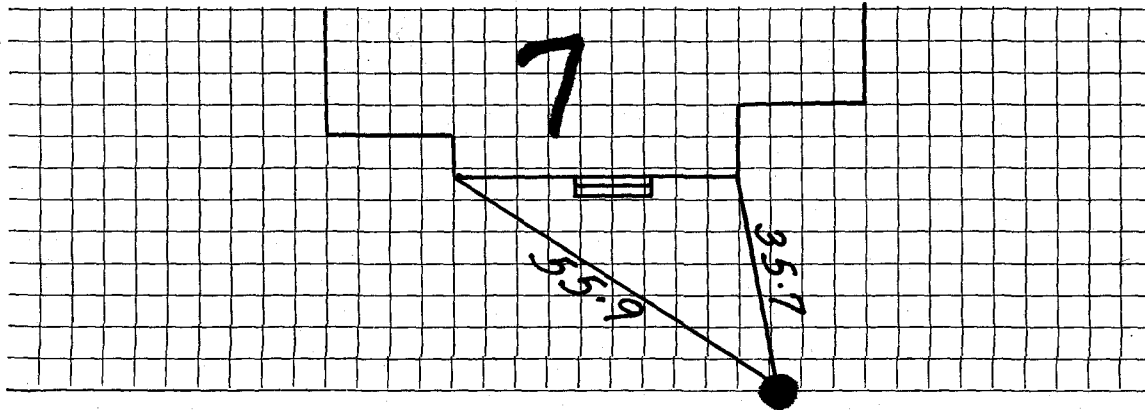

Connection made in _____ Street.

Work completed _____ 19

Remarks: