

Name Gladys Fletcher

Service No. 72

Address 9 Patriots Drive

#4974

Lexington, Mass.

Location 9 Patriots Drive

Kind of Pipe

Size

Size of Main

Repair ~~Renewal~~ New Service

Location

Date

Material

Amount

Total

Date

Amount

June 30 '48

Labor 2 10

2 10

June 21 '48
22.28 '48

Deponated
Refunded
Non-Charge

30 00

10% Overhead

21

~~23~~

61' - 1" Copper Tubing @.31

18 91

27 76

1 - 1" C x 3/4" I.W.H. S&W

3 15

1 - 3/4" Straight Tail Piece

30

2 - 1" C x 1" C Unions(3pts)

2 64

1 - 3/4" Offset Tail Piece

30

Trucking 1 hr. @.75

75

60

27 76

Com. 10/25/48

Labor

Hadley Press, Inc., Lexington

DATE _____

TOWN OF LEXINGTON—BOARD OF PUBLIC WORKS

WATER DIVISION

The undersigned applies for a supply of water at No. _____ St. and hereby agrees to comply with the rules and regulations as now, or at any future time, established by the Board of Selectmen.

Am't. of Estimate \$ _____


Owner _____

Am't. Paid \$ _____

Address _____

Builder _____

Sketch of Service Here

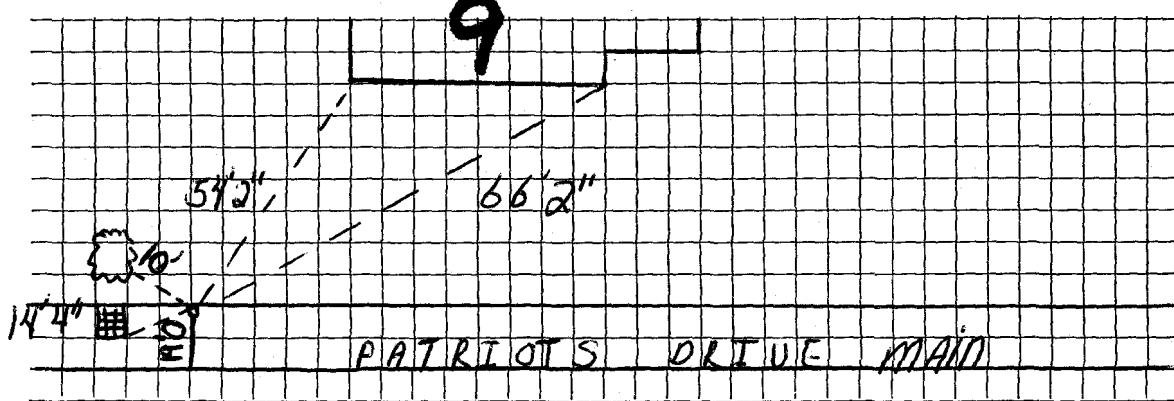

Connection made in _____ Street.

Work completed _____ 19

Remarks: