

WATER SERVICE RECORD

Name Kenneth Covey

Service No.

281 #14

Address 17 Patterson Road

Location

Report ~~Renewal~~ - New Service

Com. 12-31-51


| Date | Material | Amount | Total | Date | Amount |
|----------|------------------------------|--------|-------|-----------------------------|---------|
| 11-16-51 | Labor | 1 49 | 1 49 | 11-7-51 Deposited | 45 00 |
| | 10% Overhead | | 15 | 12-31-51 Re-fund | (20 59) |
| | 50'-3/4" Copper Tubing @.320 | | 16 30 | | 24 41 |
| | 1-3/4"Cx1/2 I.W.H. S&W | | 4 00 | No Charge | |
| | 1-3/4"Cx3/4"C Union (3pts) | | 1 72 | 11-16-51 Labor | 4 58 |
| | 1 Hr. Trucking | | 75 | 10'-3/4"Copper Tubing :.326 | 3 26 |
| | Total | | 24 41 | 1-3/4"C Corp Cock | 4 33 |
| | | | | 1-3/4Cx3/4"C Curb Cock | 4 67 |
| | | | | 1-Box & Rod | 4 68 |
| | | | | 1-1/2 Straight Tail Piece | 50 |
| | | | | 1-1/2 Offset Tail Piece | 50 |
| | | | | 1 Hr. Trucking | 75 |
| | Trench Dug By Owner | | | Total | 23 27 |

DATE _____

TOWN OF LEXINGTON — BOARD OF PUBLIC WORKS

WATER DIVISION

Sketch of Service Here

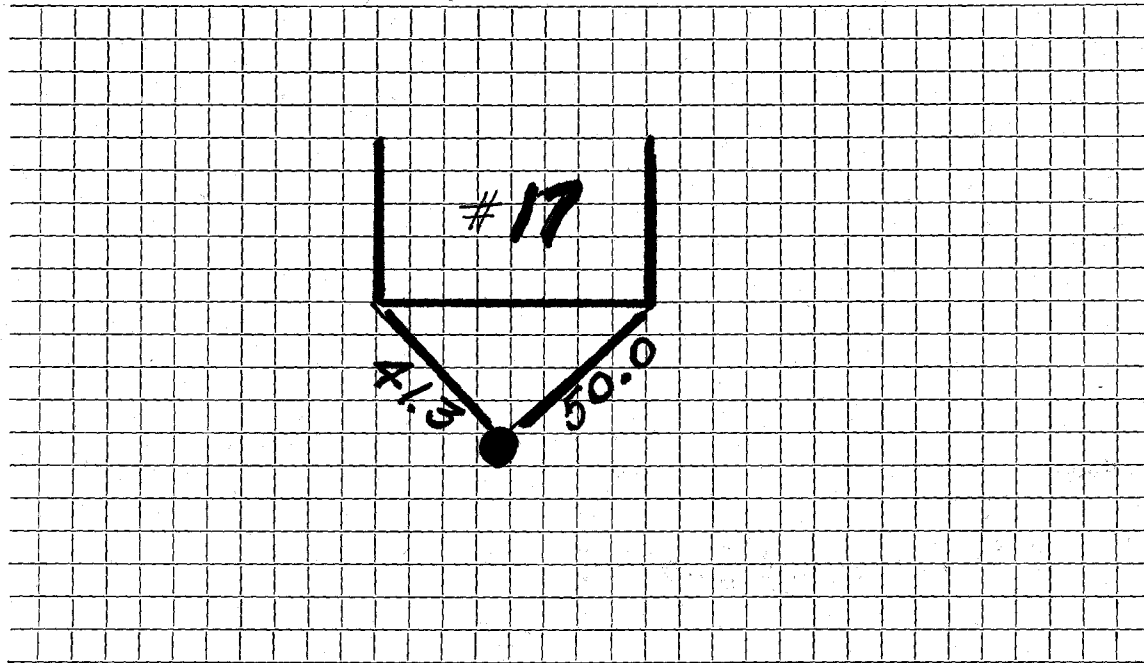

Connection made in Street. Work completed

Remarks:

.....

.....