

WATER SERVICE RECORD

Name Donald Ranney

Service No. ^{#2571} 256

Address 18 Patterson Road

#7164

Location

~~Repair~~ ~~Renewal~~ - New Service

Com. 12-31-51


Date	Material	Amount	Total	Date	Amount
11-16-51	Labor	1 49	1 49	10-20-51	Deposited 45 00
	10% Overhead		15	12-31-51	Refunded (23 94)
	45' - 3/4" Copper Tubing @ .326		14 67		21 06
	1-3/4" C x 1/2" I.W.H. S&W		4 00		No Charge
	1 Hr. Trucking		75	11-16-51	Labor 4 58
	Total		21 06	27'-3/4" Copper Tubing @ .326	8 80
				1-3/4" C Corp Cock	4 33
				1-3/4" C x 3/4" C Curb Cock	4 67
				1-Box & Rod	4 68
				1-1/2 Straight Tail Piece	50
				1-1/2 Offset Tail Piece	50
				1 Hr. Trucking	75
				Total	28 81

DATE _____

TOWN OF LEXINGTON — BOARD OF PUBLIC WORKS

WATER DIVISION

Sketch of Service Here

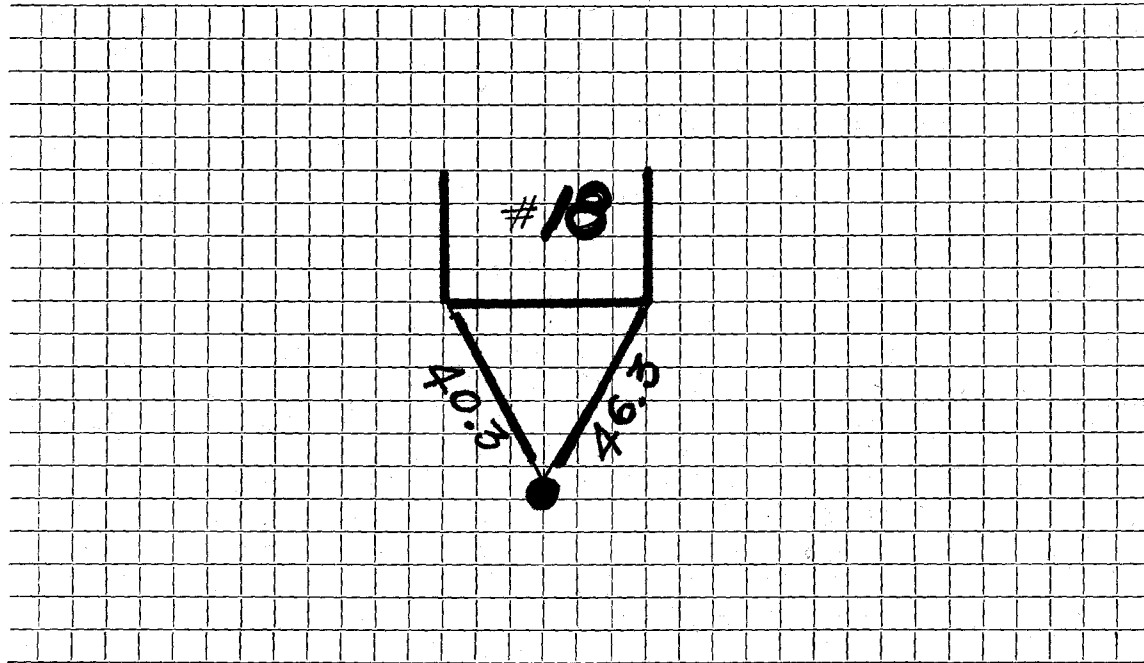

Connection made in Street. Work completed

Remarks:

.....

.....