

WATER SERVICE RECORD

843

Name Lexington Construction Co.

Service No. 329

Address 23 Patterson Road

Location Lexington, Mass.

~~Repair Estimate~~ - New Service


Com. 12-26-50

| Date | Material | Amount | Total | Date | Amount |
|-------------|--------------------------------|--------|-------|---------------------------------|---------------------------------|
| Nov. 9, '50 | Labor | 2 79 | 2 79 | Oct 24 '50 | Deposited 20 00 |
| | 10% Overhead | | 28 | 8-17-51 | Paid 13 73 |
| | 78' - 3/4" Copper Tubing @.32 | 24 96 | 24 96 | 3-17-52 | Adjusted No Charge 12 |
| | 1 - 3/4"C x 1/2" I.W.H. S&W | 3 76 | 3 76 | | 1 - 1/2" Offset Tail Piece 42 |
| | 1 - 3/4"C x 3/4"C Union (3pts) | 1 61 | 1 61 | | 1 - 1/2" Straight Tail Piece 42 |
| | Trucking 1 hr. @.75 | | 75 | | 84 |
| | | | 34 15 | | |
| | | | | Service was in to curb | |
| | | | | Trench dug by owner | |
| | | | | 9-29-50 Labor | 8 66 |
| | | | | 6' - 3/4" Copper Tubing @.31 | 1 86 |
| | | | | 1 - 3/4"C Corp-cock | 3 60 |
| | | | | 1 - 3/4"C x 3/4"C Curb-cock | 4 40 |
| | | | | 1 - Box & Rod | 3 35 |
| | | | | Littlefield Shovel 2 hr. @ 7.00 | 7 00 |
| | | | | Trucking 1 hr. @.75 | 75 |
| | | | | | 29 62 |
| | | | | | 84 |
| | | | | | 30 46 |

DATE _____

TOWN OF LEXINGTON — BOARD OF PUBLIC WORKS
WATER DIVISION

Sketch of Service Here

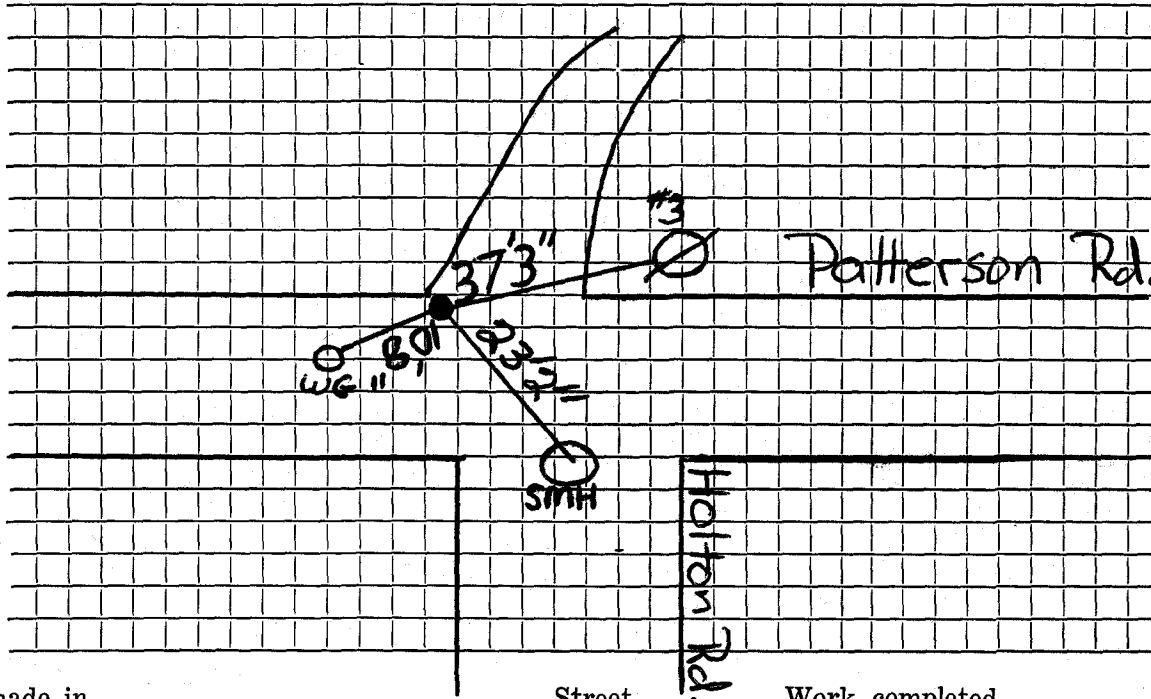

Connection made in Street. Work completed

Remarks:

.....
.....