


DATE 10/29/11

TOWN OF LEXINGTON — BOARD OF PUBLIC WORKS WATER DIVISION

Sketch of Service Here

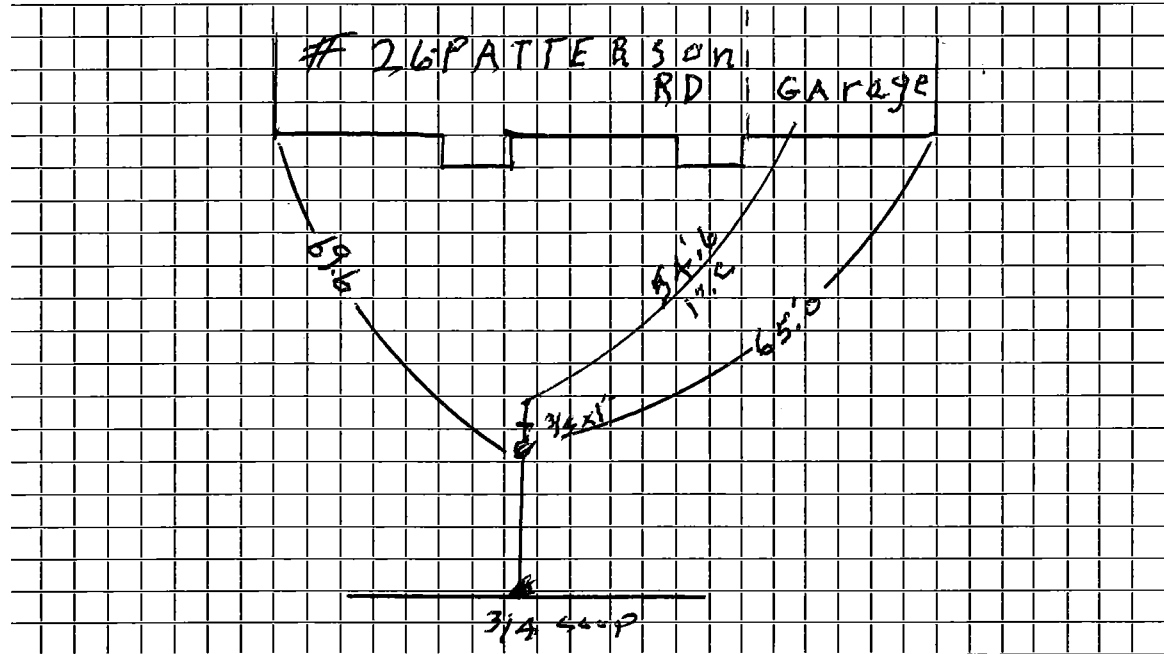

Connection made in Street.

Work completed 10/29/11 J. McLaughlin.....

Remarks: 1959 Repair out side.....

.....

.....