

WATER SERVICE RECORD

Name

Service No.

Address **27 Patterson Road (lot 15)**

Location **Lexington**

~~Repair/Replacement~~ **New Service**

SERVICE TO CURB:


Date	Material	Amount	Total	Date	Amount
11-14-52	86' 3/4" Copper				
	1 3/4" X 1/2" I.W.H. Stop & Waste				
	1 3/4" UNION				
					<u>NON CHARGE</u>
				10/21/52 Labor	2 92
				13' - 3/4" copper tubing @ .34	4 42
				1 - 3/4" C. corp-cock	4 33
				1 - 3/4" C x 3/4" C. curb-cock	4 67
				1 box and rod	3 90
				1 hr. trucking	75
					<u>20 99</u>

DATE _____

TOWN OF LEXINGTON — BOARD OF PUBLIC WORKS

WATER DIVISION

Sketch of Service Here

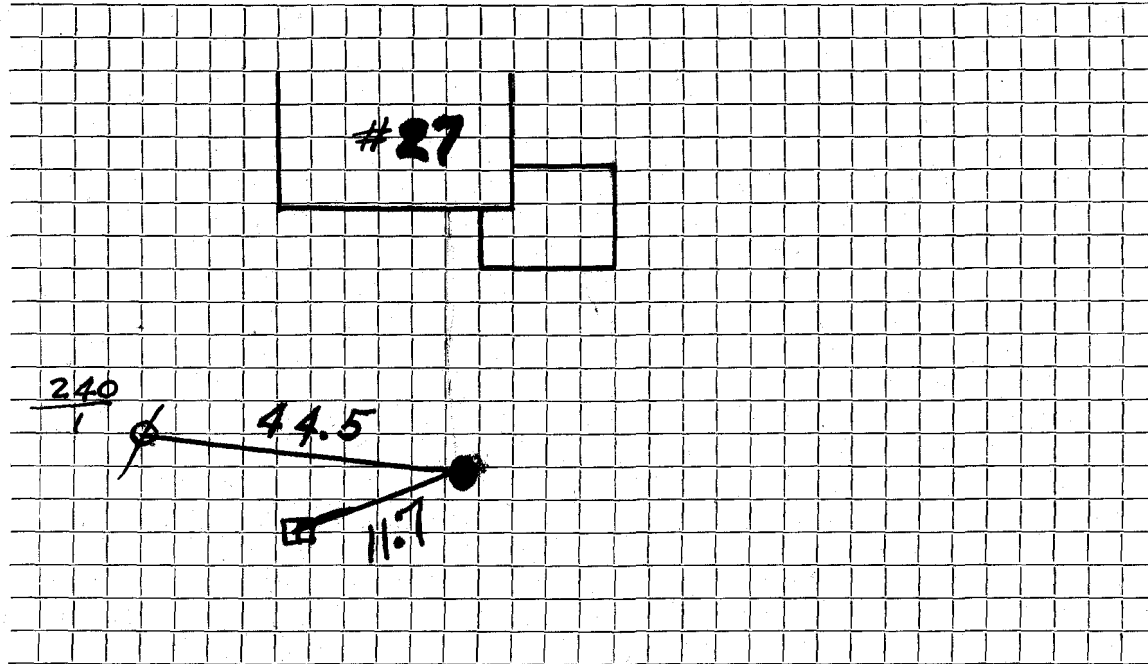

Connection made in Street. Work completed

Remarks:

.....

.....