

WATER SERVICE RECORD

Name

Service No.

Address 28 Patterson Road (Lot 9)

Location Lexington

~~Repair/Alteration~~ — New Service

SERVICE TO CURB:


Date	Material	Amount	Total	Date	Amount
11-25-52	60' 3/4" Copper				
	1 3/4" X 1/2" I.W.H. Stop & Waste				
					<u>NON CHARGE</u>
				10/21/52 Labor	2 93
				21' - 3/4" copper tubing @ .34	7 14
				1 - 3/4" C. corp-cock	4 33
				1 - 3/4" C. curb-cock	4 67
				1 box and rod	3 90
				1 hr. trucking	75
					23 72

DATE _____

TOWN OF LEXINGTON — BOARD OF PUBLIC WORKS

WATER DIVISION

Sketch of Service Here

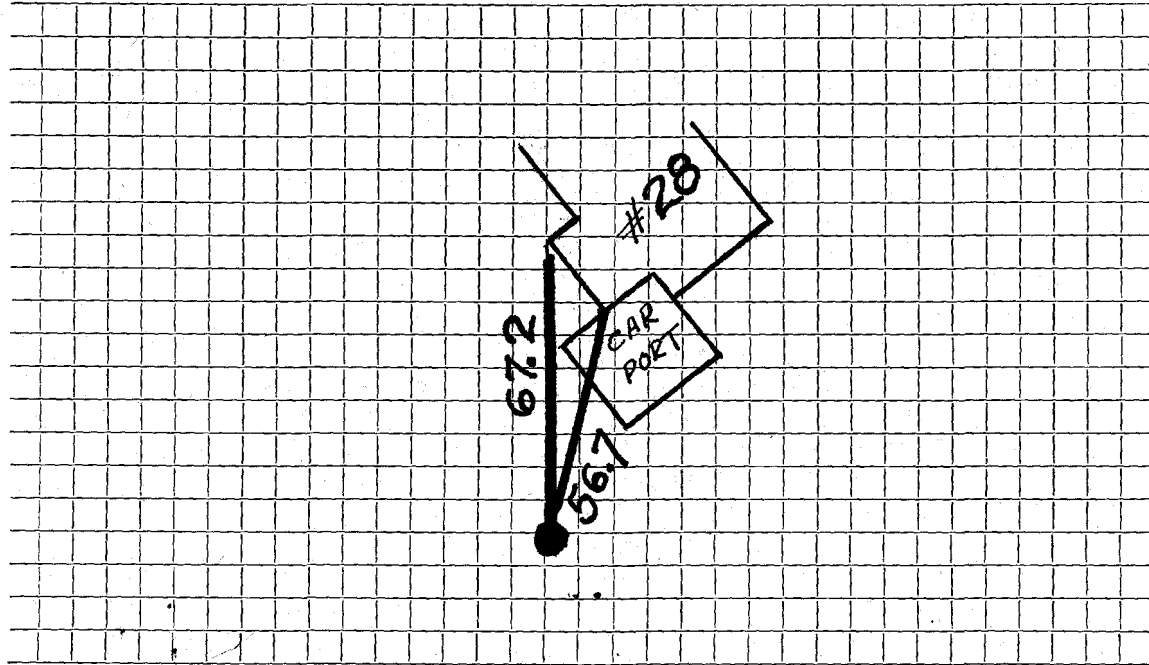

Connection made in Street. Work completed

Remarks:
.....
.....