

WATER SERVICE RECORD

Name

Service No.

Address 29 Patterson Road (lot 14)

Location Lexington

~~Repair/Replacement~~ New Service

SERVICE TO CURB.


Date	Material	Amount	Total	Date	Amount
11-14-52	55' 3/4" Copper				
	1 3/4" C. X 1/2" I.W.H. Stop + Waste				
					<u>NON CHARGE</u>
				10/21/52	Labor 2 92
				7' - 3/4" copper tubing @ .34	2 38
				1 -3/4" C. corp-cock	4 33
				1 -3/4" C x 3/4" C.curb-cock	4 67
				1 box and rod	3 90
				1 hr. trucking	75
					<u>18 95</u>

DATE _____

TOWN OF LEXINGTON — BOARD OF PUBLIC WORKS

WATER DIVISION

Sketch of Service Here

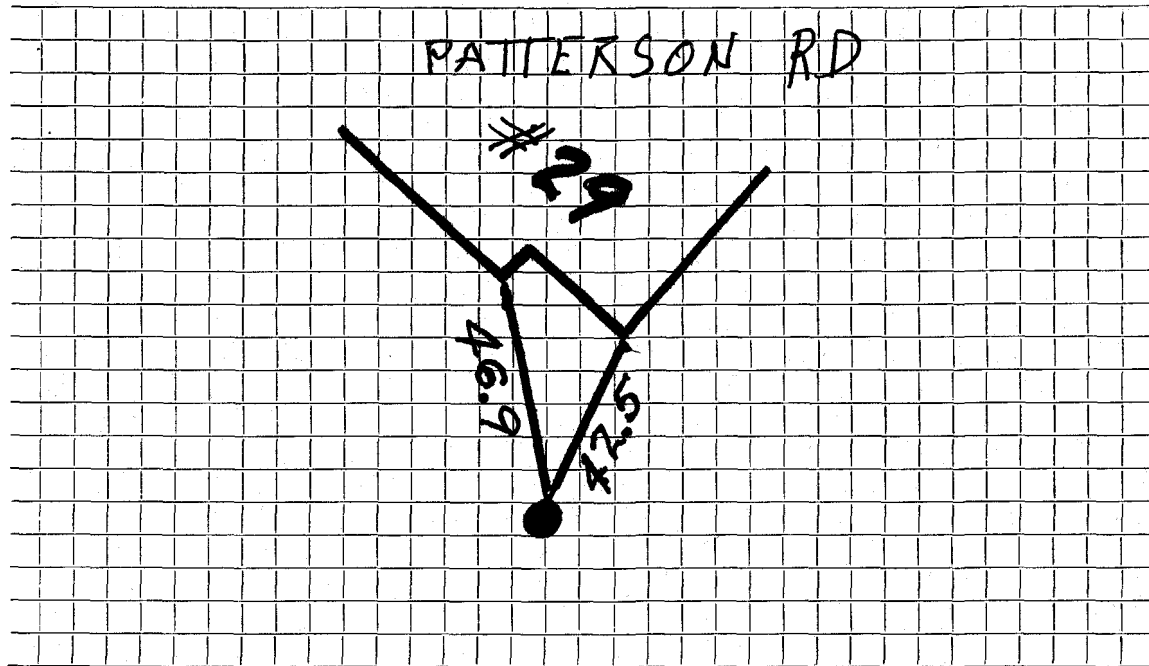

Connection made in Street. Work completed

Remarks:
.....
.....