

WATER SERVICE RECORD

Service No. ✓

Name

Address **3 Patterson Road (lot 25)**

Location **Lexington**

~~Repair Work~~ **New Service**

SERVICE TO CURB


| Date | Material | Amount | Total | Date | Amount | |
|---------|--|--------|-------|--|-------------------|-----------|
| 3-15-55 | 32' $\frac{3}{4}$ " Copper | | | | | |
| | 1 $\frac{3}{4}$ " C. X $\frac{1}{2}$ " I.W.H. Stop + Waste | | | | | |
| | | | | | <u>NON CHARGE</u> | |
| | | | | 10/20/52 | Labor | 3 66 |
| | | | | 28' $\frac{3}{4}$ " copper tubing @.34 | | 9 52 |
| | | | | 1 $\frac{3}{4}$ " C. corp-cock | | 4 33 |
| | | | | 1 $\frac{3}{4}$ " C x $\frac{3}{4}$ " C. curb-cock | | 4 60 |
| | | | | 1 box and rod | | 3 90 |
| | | | | 1 hr. trucking | | <u>75</u> |
| | | | | | | 26 83 |

DATE _____

TOWN OF LEXINGTON — BOARD OF PUBLIC WORKS

WATER DIVISION

Sketch of Service Here

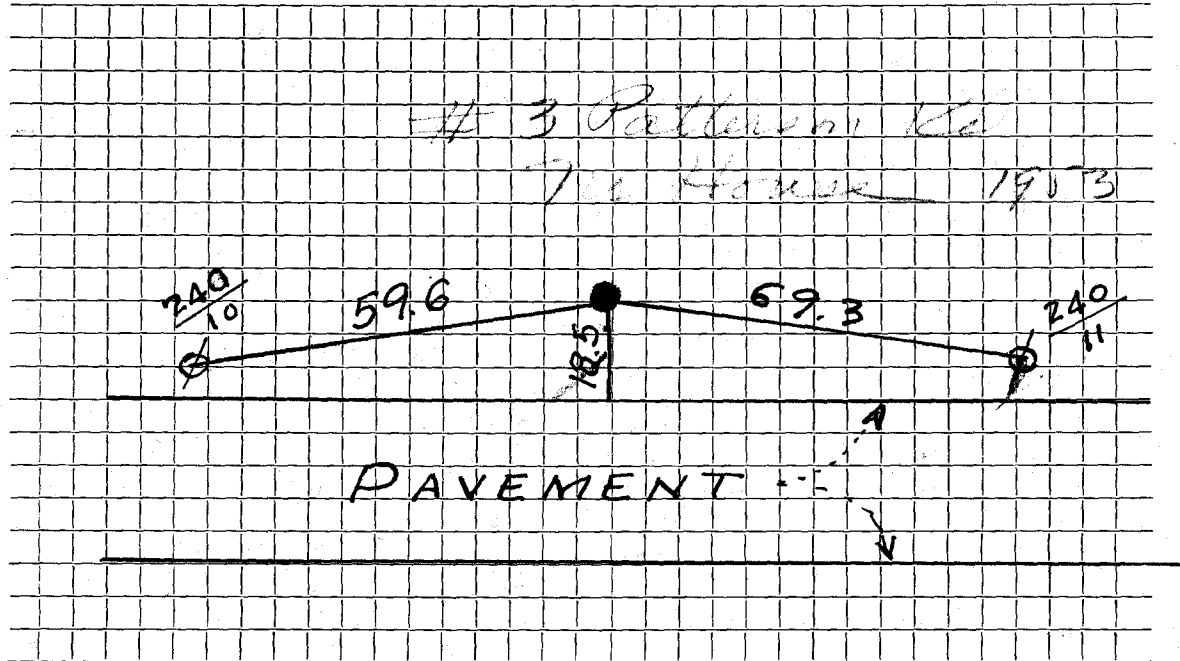

3 Patterson Rd
The House 1903

Connection made in Street. Work completed

Remarks:
.....
.....