


Water Service Tie Card  
**TOWN OF LEXINGTON**  
 MASSACHUSETTS

**30 Patterson Rd**

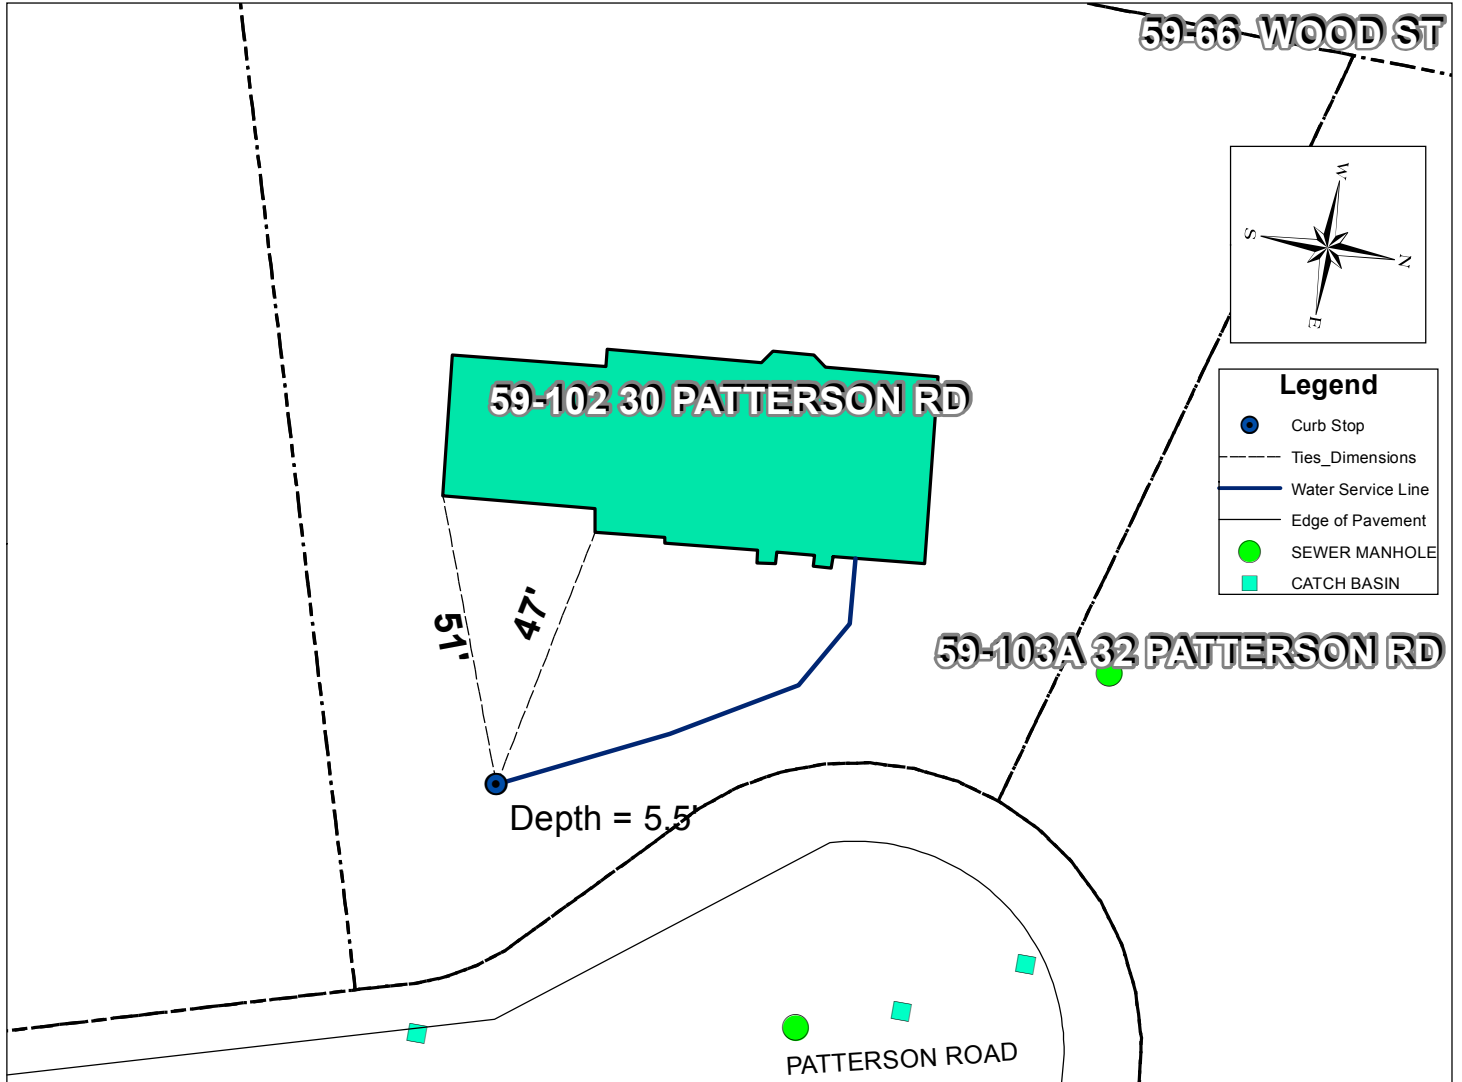

Address	Map and Lot	Permit Number	Contractor Name	Inspector
30 Patterson Rd	59-102	6374	Susi & Mascio	msprague
Date	Material	Depth of Cover	Amount	
9/3/2015	1" Curb Valve and Buffalo Box	5.5 ft	1	
	1" Copper type "k"	5.5 ft	76 ft to HSE	
Type of work completed				

New 1" water service to house from curb stop. New house on lot old house removed.