

WATER SERVICE RECORD

Name

Service No.

Address 31 Patterson Road (lot 13)

Location

~~Repair~~ New Service

SERVICE TO CURB


Date	Material	Amount	Total	Date	Amount
11-25-52	55' 3/4" Copper				
	1 3/4" C. X 1/2" I.W.H. STop + Waste				
					<u>NON CHARGE</u>
				10/21/52 Labor	2 92
				40' - 3/4" copper tubing@ .34	13 60
				1 -3/4" C. corp-cock	4 33
				1 -3/4" C x 3/4" C.curb-cock	4 67
				1 box and rod	3 90
				1 hr. trucking	75
					30 17

DATE _____

TOWN OF LEXINGTON — BOARD OF PUBLIC WORKS

WATER DIVISION

Sketch of Service Here

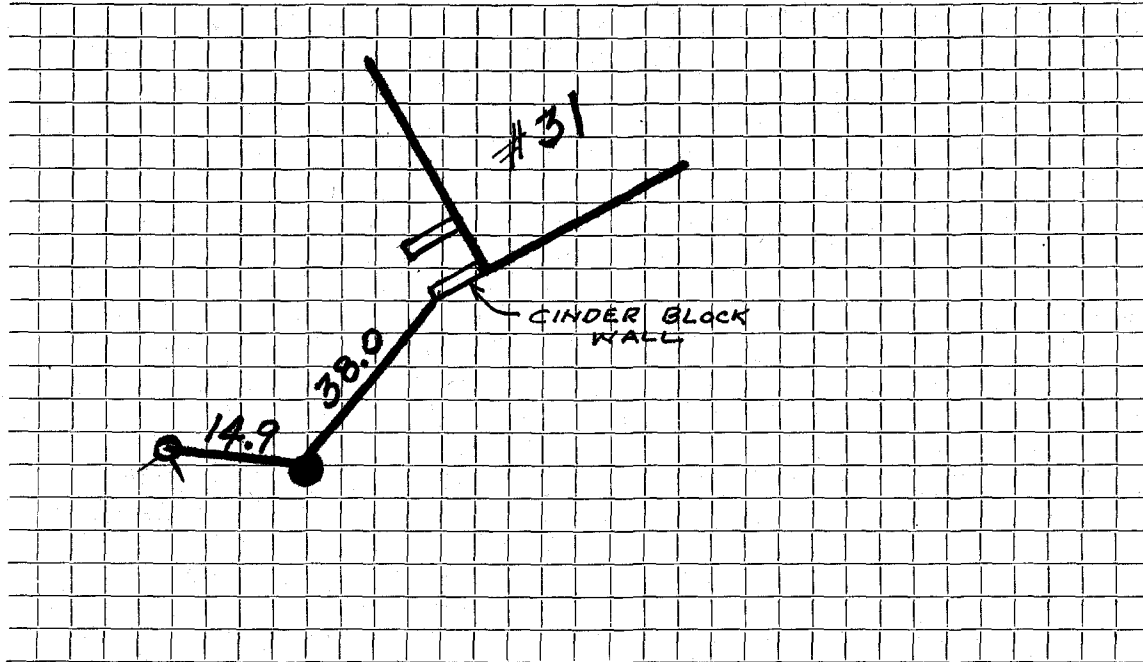

Connection made in Street. Work completed

Remarks:
.....
.....