

WATER SERVICE RECORD

Name

Service No.

Address 32 Patterson Rd. (lot 12)

Location Lexington

~~XXXXXX~~ ~~XXXXXX~~ - New Service

Date	Material	Amount	Total	Date	Amount
5-22-53	75' 3/4" Copper				
	1 3/4" C. X 1/2" I.W.H. STOP & WASTE				
	1 3/4" C. X 3/4" - 3 Part Union				
				10/21/52 Labor	2 92
				40' - 3/4" copper tubing @ .34	13 60
				1 - 3/4" C. corp-cock	4 33
				1 - 3/4" C x 3/4" C. curb-cock	4 67
				1 box and rod	3 90
				1 hr. trucking	75
					<u>30 17</u>


NON CHARGE

DATE \_\_\_\_\_

**TOWN OF LEXINGTON — BOARD OF PUBLIC WORKS**

**WATER DIVISION**

Sketch of Service Here

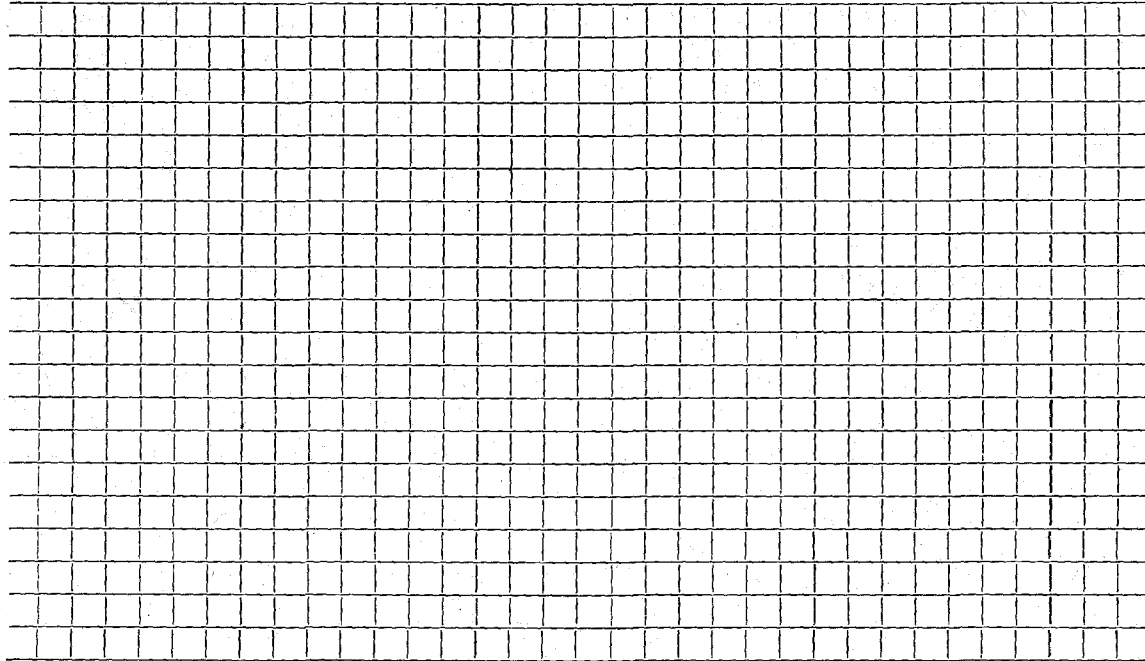

Connection made in ..... Street.                      Work completed ..... ✓

Remarks: .....  
.....  
.....