

WATER SERVICE RECORD

Name

Service No.

Address 4 Patterson Road (lot 41)

Location Lexington

Repair/Removal - New Service

SERVICE TO CURB


Date	Material	Amount	Total	Date	Amount
5-28-54	45' 3/4" Copper				
	1 3/4" C. x 1/2" I.W.H. Stop + Waste				
					<u>NON CHARGE</u>
				10/20/52 Labor	3 66
				20' - 3/4" copper tubing @ .34	6 80
				1 - 3/4" C. corp-cock	4 33
				1 - 3/4" C x 3/4" C. curb-cock	4 67
				1 box and rod	3 90
				1 hr. trucking	75
					24 11

DATE \_\_\_\_\_

TOWN OF LEXINGTON — BOARD OF PUBLIC WORKS

WATER DIVISION

Sketch of Service Here

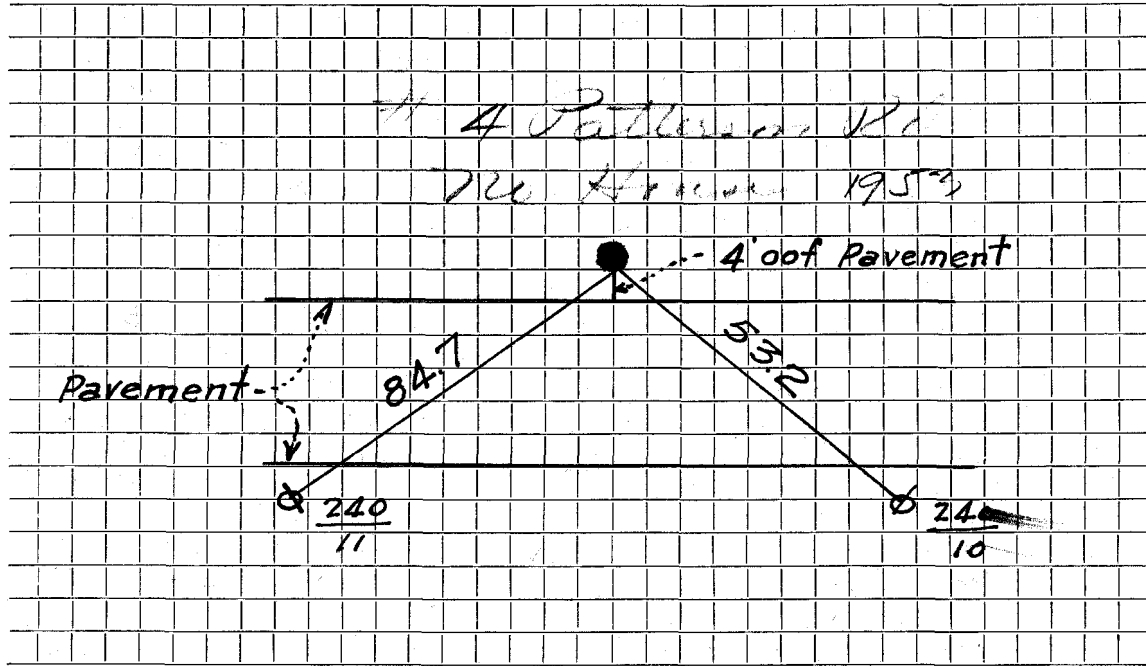

Connection made in ..... Street. Work completed .....

Remarks: .....

.....

.....