

WATER SERVICE RECORD

Name

Service No.

Address 5 Patterson Road (lot 24)

Location Lexington


~~Repair/Extension~~ New Service

Date	Material	Amount	Total	Date	Amount
8/4/54	28' 3/4 COPPER				
	1 3/4 x 1/2 S+W				
				<u>NON CHARGE</u>	
				10/20/52 Labor	3 67
				7' - 3/4" copper tubing@ .34	2 38
				1 -3/4" C.corp-cock	4 33
				1 -3/4" C x 3/4" C.curb-cock	4 67
				1 box and rod	3 90
				1 hr. trucking	75
					<u>19 70</u>
				SERVICE TO CURB.	

TOWN OF LEXINGTON — BOARD OF PUBLIC WORKS

WATER DIVISION

Sketch of Service Here

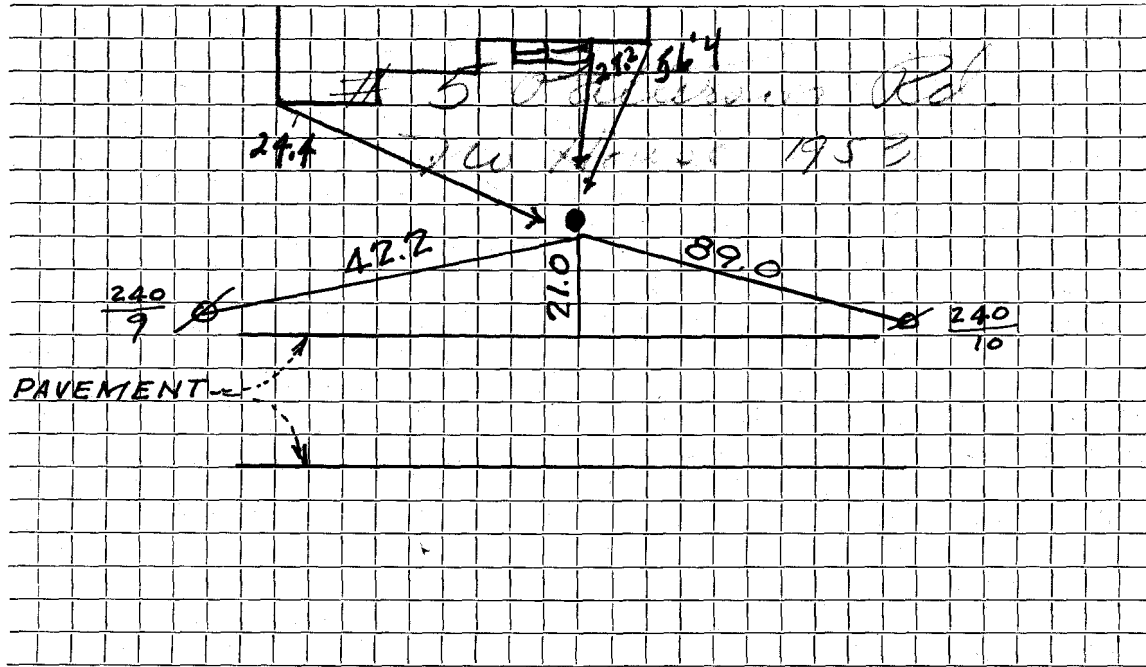

Connection made in Street. Work completed

Remarks:
.....
.....