

WATER SERVICE RECORD

Name

Service No.

Address **6 Patterson Road (lot 40)**

Location **Lexington**

~~Repair/Renewal~~ **New Service**


SERVICE TO CURB.

Date	Material	Amount	Total	Date	Amount
11-25-52	80' $\frac{3}{4}$ " Copper				
	1 $\frac{3}{4}$ " C. X $\frac{1}{2}$ " I. W. H. Stop + Waste			<u>NON CHARGE</u>	
	1 $\frac{3}{4}$ " C. X $\frac{3}{4}$ " C. Union			10/20/52	Labor
				21' - $\frac{3}{4}$ " copper tubing@ .34	3 66
				1 - $\frac{3}{4}$ " C. corp-cock	7 14
				1 - $\frac{3}{4}$ " C. curb-cock	4 33
				1 box and rod	4 67
				1 hr. trucking	3 90
					<u>75</u>
					24 45

DATE _____

TOWN OF LEXINGTON — BOARD OF PUBLIC WORKS
WATER DIVISION

Sketch of Service Here

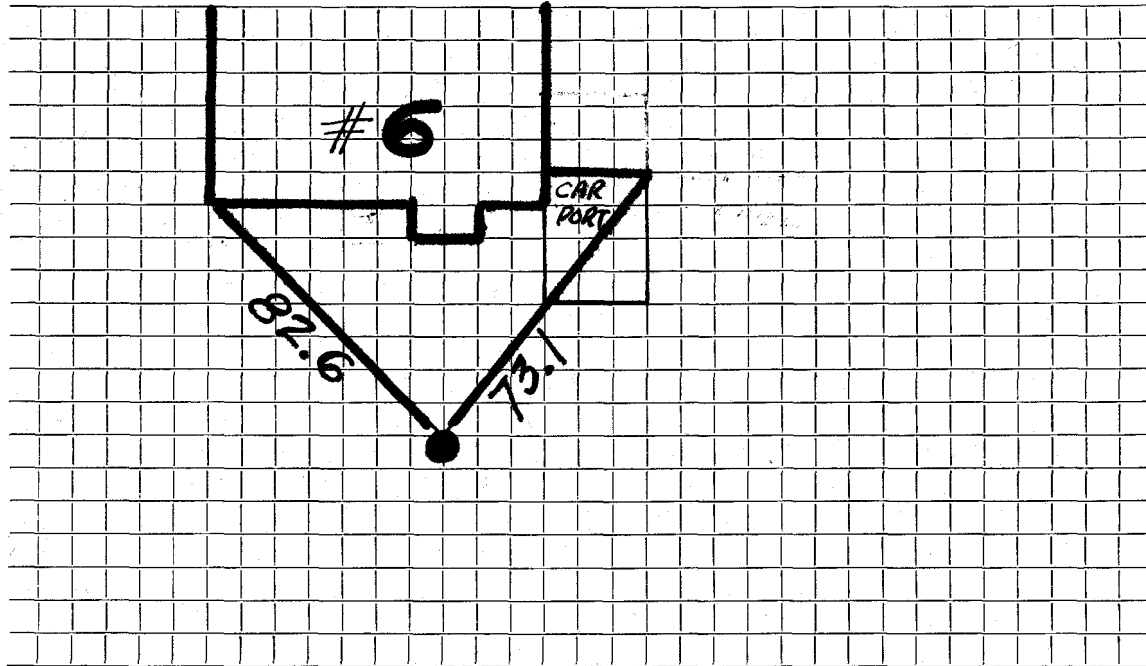

Connection made in Street. Work completed

Remarks:
.....
.....