

WATER SERVICE RECORD

Name

Service No.

Address 7 Patterson Road (lot 23)

Location Lexington

~~Repair~~ ~~Extension~~ — New Service


SERVICE TO CURB

Date	Material	Amount	Total	Date	Amount
12-8-52	55' $\frac{3}{4}$ " Copper				
	1 $\frac{3}{4}$ " X $\frac{1}{2}$ " I. W. H. Stop & Waste				
					<u>NON CHARGE</u>
				10/20/52 Labor	3 67
				7' - $\frac{3}{4}$ " copper tubing @ .34	2 38
				1 - $\frac{3}{4}$ " C. corp-cock	4 33
				1 - $\frac{3}{4}$ " C x $\frac{3}{4}$ " C. curb-cock	4 67
				1 - box and rod	3 90
				1 - hr. trucking	75
					19 70

DATE _____

TOWN OF LEXINGTON — BOARD OF PUBLIC WORKS
WATER DIVISION

Sketch of Service Here

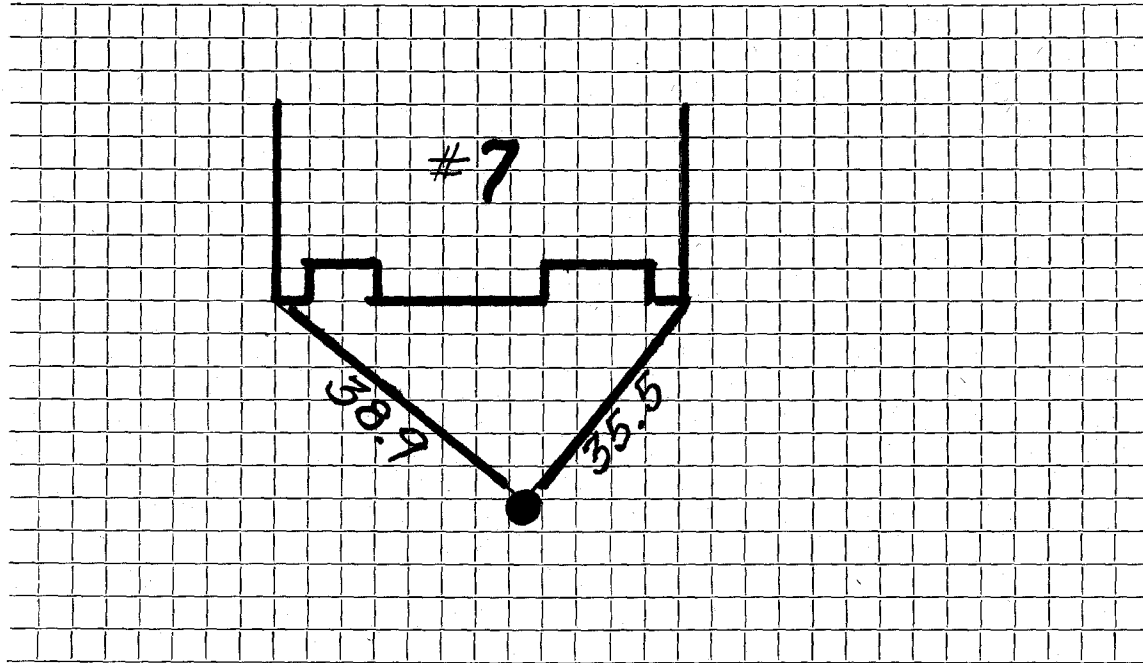

Connection made in Street. Work completed

Remarks:
.....
.....