

WATER SERVICE RECORD

#4053

Name Lexington Construction Co.

Service No. 277

Address 8 Patterson Road

Location Lexington

~~REPAIR/REWORK~~ - New Service

Com. 11-24-52


Date	Material	Amount	Total	Date	Amount
10/20/52	Labor	1 63		10-22-52	Deposited 30 -
	10% overhead	16	1 79	11-24-52	Refunded 9 (8 16)
	45' - 3/4" copper tubing@ .34		15 30		credited to acct. due on W.S.C. #201
	1 - 3/4" C x 1/2 I.W.H. stop & waste		4 00		<u>NON CHARGE</u>
	1 hr. trucking		75	10/20/52	Labor 2 95
			21 84		25' - 3/4" copper tubing@ .34 8 50
	TRENCH DUG BY OWNER				1 - 3/4" C. corp-cock 4 33
					1 - 3/4" C x 3/4" C. curb-cock 4 67
					1 box and rod 3 90
					1 - 1/2 offset tail piece 50
					1 - 1/2 straight tail piece 50
					1 - hour trucking 75
					<u>26 10</u>

DATE \_\_\_\_\_

**TOWN OF LEXINGTON — BOARD OF PUBLIC WORKS**

**WATER DIVISION**

Sketch of Service Here

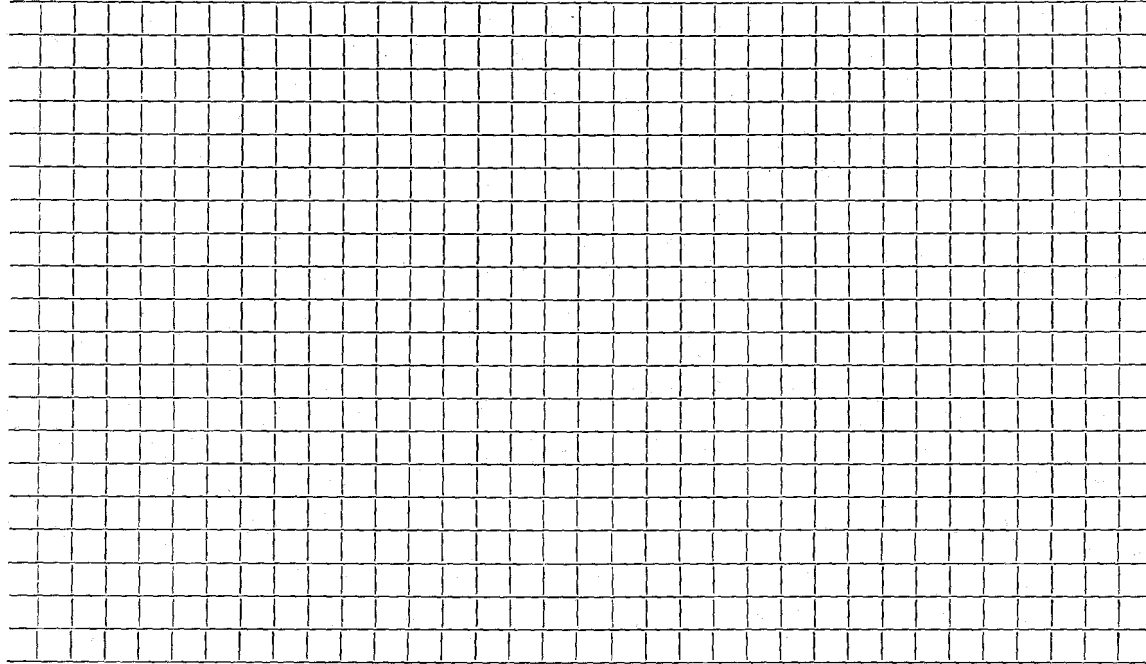

Connection made in ..... Street.                      Work completed .....

Remarks: .....  
.....  
.....