

Name Ross Realty Corp.,

Service No. ~~506~~ 2188

Address 173 Bedford St., Lexington  
10 Paul Revere Rd.

#3869

Location 10 Paul Revere Road.

Kind of Pipe

Size

Size of Main

Repair—Renewal—New Service

Location

Date  
1941

Material

Amount

Total

Date

Amount

September 24, 2 hrs. @ 60¢

1 20

September 27, 1941

Deposited

16 00

10% Overhead

12

1 32

October 21, 1941 Refund

3 64

41' 3/4" Copper tubing @ 19¢

7 79

1 3/4" C.S.& W.

2 50

Trucking, 1 hr.

75

12 36

12 36

Labor

Hadley Press, Inc., Lexington

DATE September 20, 1941

TOWN OF LEXINGTON—BOARD OF PUBLIC WORKS  
**WATER DIVISION**

The undersigned applies for a supply of water at No. 10 Paul Revere Road ~~St~~ and hereby agrees to comply with the rules and regulations as now, or at any future time, established by the Board of Selectmen.

Am't. of Estimate \$ 16.00

Owner Ross Realty Corp.,


Am't. Paid \$ \_\_\_\_\_

Address 173 Bedford St.,

Builder \_\_\_\_\_

Lexington, Mass.

Sketch of Service Here

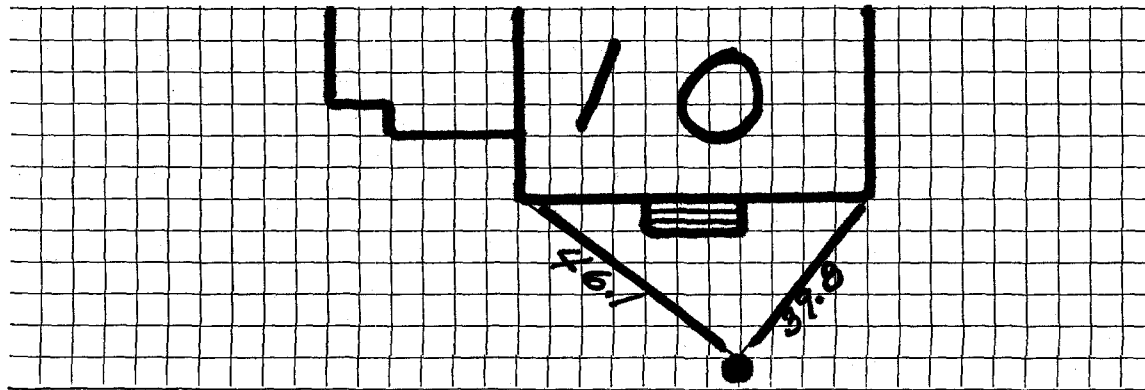

Connection made in \_\_\_\_\_ Street.

Work completed \_\_\_\_\_ 19

Remarks: