

WATER SERVICE RECORD

Name **DeVries Const. Co.**

Service No. **290**

Address **11 Paul Revere Rd.**

2864

Location **Lexington**

~~REPAIRS~~ New Service


COM. 12-31-52

Date	Material	Amount	Total	Date	Amount
12/31/52	Labor	10 00		10-29-52	Deposited 65 00
	10% overhead	1 00	11 00	12-31-52	Refused 85
	60' - 3/4" copper tubing @ .34	20 40			NON CHARGE 64 15
	1 - 3/4" C x 1/2 I.W.H. stop & waste	4 00		12/31/52	Labor 18 65
	2 hrs. town shovel @ 5.00	10 00		26' - 3/4" copper tubing @ .34	8 84
	1 hr. trucking	75		1 - 3/4" Copper corp-cock	4 33
	patching 18 x 3	18 00		1 - 3/4" C x 3/4" C. curb-cock	4 67
			64 15	1 box and rod	3 90
				1 - 1/2 offset tail piece	50
				1 - 1/2 straight tail pc.	50
				2 hrs. town shovel	10 00
				1 hr. trucking	75
					<u>52 14</u>

DATE _____

TOWN OF LEXINGTON — BOARD OF PUBLIC WORKS
WATER DIVISION

Sketch of Service Here

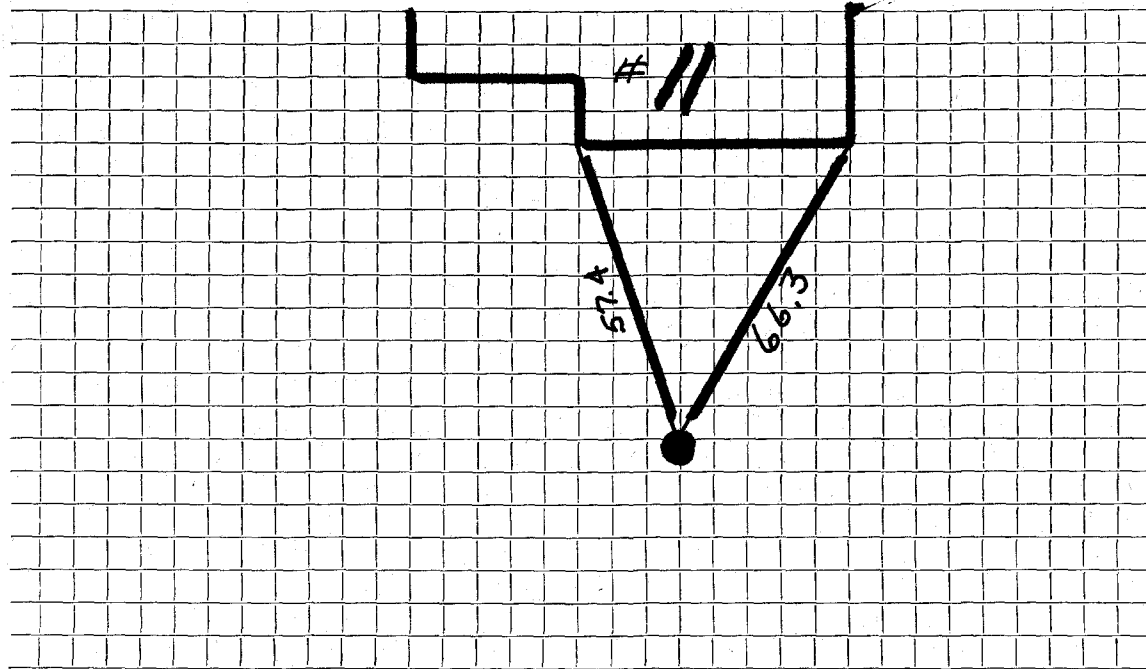

Connection made in Street. Work completed

Remarks:
.....
.....