

Name Ross Realty Corp.,

Service No. ~~110~~ 2189

Address 173 Bedford St., Lexington
12 Paul Revere Rd.

#6943

Location 12 Paul Revere Road.

Kind of Pipe

Size

Size of Main

Repair—Renewal—New Service

Location

Date
1941

Material

Amount

Total

Date

Amount

Nov. 8

2 hrs. @ 60¢

1 20

1 20

September 22, 1941

Deposited

16 00

Com 12/24/41

10% Overhead

12

Dec 29, 1941

Refund

3 40

37' 3/4" Copper tubing @ 19¢

7 03

1 3/4" C.x 1/2" I.S.& W.

2 50

1 3/4" C.Union 3 parts

1 00

1 hr. trucking @ 75¢

75

12 60

12 60

Labor

Hadley Press, Inc., Lexington

DATE September 20, 1941

TOWN OF LEXINGTON—BOARD OF PUBLIC WORKS
WATER DIVISION

The undersigned applies for a supply of water at No. 12 Paul Revere Road St. and hereby agrees to comply with the rules and regulations as now, or at any future time, established by the Board of Selectmen.

Am't. of Estimate \$ 16.00

Owner Ross Realty Corp.,


Am't. Paid \$ _____

Address 173 Bedford St.,

Lexington, Mass.

Builder _____

Sketch of Service Here

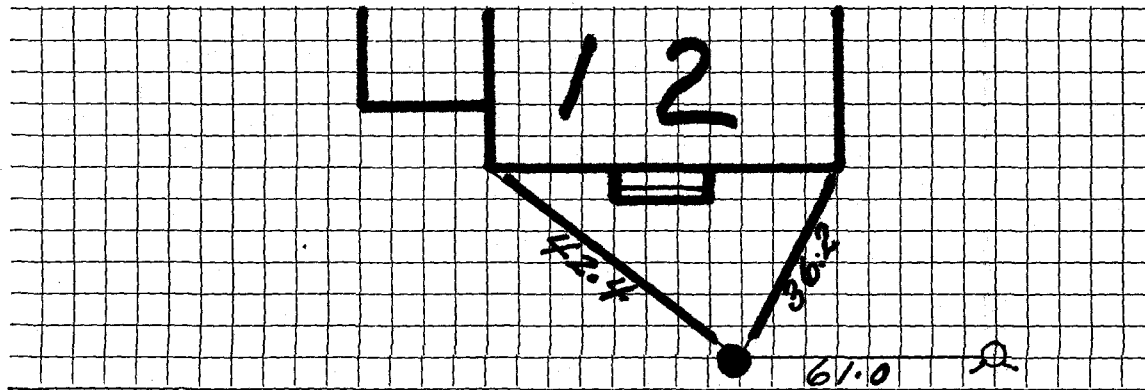

Connection made in _____ Street.

Work completed _____ 19

Remarks: