

WATER SERVICE RECORD

Name **DeVries Const. Co.**

Service No. **291 (1952)**

Address **15 Paul Revere Rd.**

2825

Location **Lexington**

~~REPAIR/RENEW~~ **New Service COM.2-16-53**


Date	Material	Amount	Total	Date	Amount
1/2/53	Labor	17 57		10-29-52	65 00
	10% overhead	1 76	19 33	2-16-53	1 04
	60'-3/4" Copper Tubing @ .34		20 40	3-4-53	8 44
	1-3/4" Cx 1/2 I.W.H. stop & Waste		4 00		<u>74 48</u>
	2 Hrs. Town Shovel @ 5.00		10 00	1/2/53	Labor 17 57
	1 Hr. Trucking		75	26'-3/4" Copper Tubing @ .34	8 84
	Patching 20 x 3		20 00	1-3/4" C. Corp-cock	4 33
			<u>74 48</u>	1-3/4" Cx 3/4" C. Curb-cock	4 67
				1- Box & Rod	3 90
				1-1/2 offset Tail Piece	50
				1-1/2 Straight Tail Piece	50
				1 Hr. Town Shovel @ 5.00	5 00
				1 Hr. Trucking	75
					<u>46 06</u>

Bill sent 2-16-53

DATE _____

TOWN OF LEXINGTON — BOARD OF PUBLIC WORKS
WATER DIVISION

Sketch of Service Here

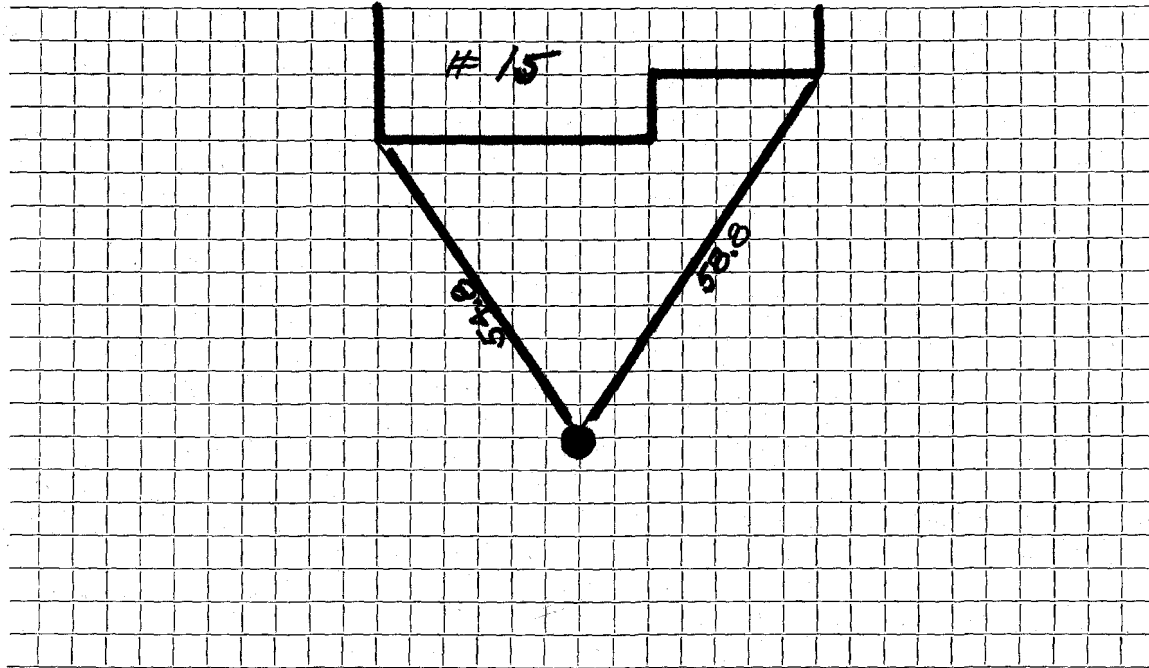

Connection made in Street. Work completed

Remarks:
.....
.....