

WATER SERVICE RECORD

Name Antonzo R. Leyenaar

Service No. 16

Address 2 Paul Revere Rd.

Location

~~Repair~~ ~~Renewal~~ New Service W0#4261 Lex. Sewerage #2823


AUG 16 1976

Date	Material	Amount	Total	Date	Amount
5/7/76	labor	62. 19		4-23-76	Deposit 400. 00
5/11/76	labor	26. 84		8-16-76	Refund 80. 97
	10%OH	8. 90			313. 03
	18' 1' copper tubing @ .83		14. 94		
	1' corp.		16. 69		
	1' curb		18. 67		
	1 box and rod		15. 40		
	2 tons cold patch @ 13.70		27. 40		
	1hr. loader @ 4.00		4. 00		
	2hr. shovel @ 6.50		13. 00		
	1hr. roller		1. 00		
	2 3/4 hr. truck @ 3.00		8. 00		
	11' X 13' patch		96. 00		
			313. 03		
5/20/76	120' 1" Copper Tubing				

DATE _____

TOWN OF LEXINGTON — BOARD OF PUBLIC WORKS

WATER DIVISION

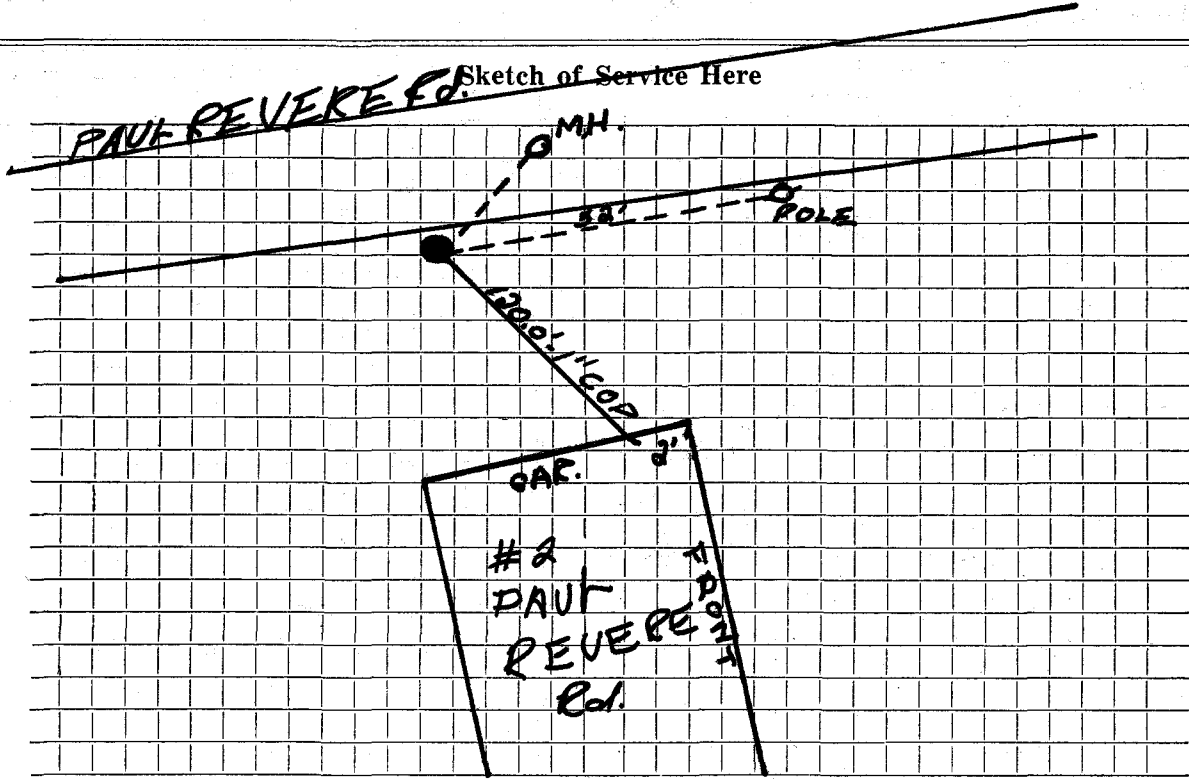

Connection made in #2 PAUL REVERE St. street.

Work completed 5/20/76

Remarks: