

WATER SERVICE RECORD

Name De Vries Const Co.

Service No. 292

Address 21 Paul Revere Rd.

987, 7441

Location Lexington

~~Repair~~ ~~Renewal~~ New Service

COM. 12-31-52


Date	Material	Amount	Total	Date	Amount
12/26/52	Labor	3 02		10-29-52 Deposited	65 00
	10% overhead	30	3 32	12-31-52 Refunded	(14 53)
	60'-3/4" Copper tubing @.34		20 40		NON-CHARGE
	1-3/4" Cx 1/2" I.W.H. stop & waste		4 00	12/26/52 Labor	3 02
	2 Hrs Littlefield Shovel		14 00	12'-3/4" Copper tubing @.34	4 08
	1 Hr trucking		75	1-3/4" C. Corp.- Cock	4 33
	Patching 6 x 3		6 00	1-3/4" Cx 3/4" C. Curb-cock	4 67
			48 47	1-Box & Rod	3 90
				1-1/2 offset tail piece	50
				1-1/2 straight tail piece	50
				1 hr. Littlefield shovel	7 00
				1 Hr. Trucking	75
					28 75

DATE _____

TOWN OF LEXINGTON — BOARD OF PUBLIC WORKS

WATER DIVISION

Sketch of Service Here

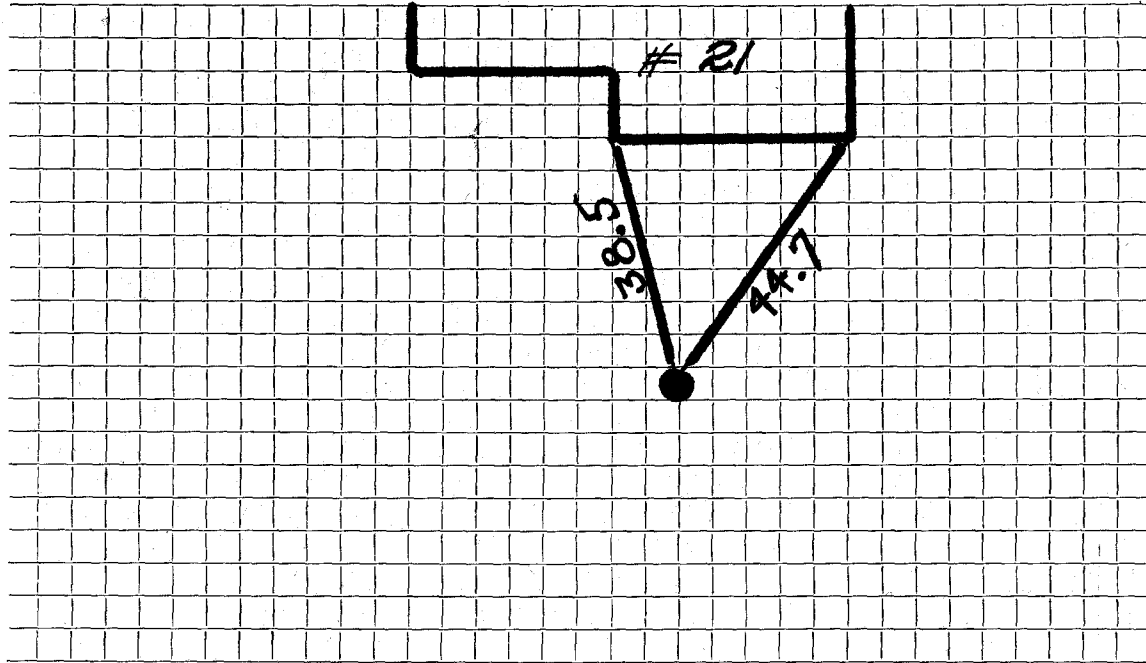

Connection made in Street. Work completed

Remarks:
.....
.....