

Name Ross Realty Corp.,

Service No. ~~145~~ 651

Address Lexington, Mass.  
22 Paul Revere Road.

22 Paul Revere Road

# 6214

# 6215

Location

~~XXXXXXXXXXXXXXXXXX~~

Kind of Pipe

Size

Size of Main

Repair—Renewal—New Service

Location

Date  
1941

Material

Amount

Total

Date

Amount

Nov. 22,

2 hrs. @ 60¢

1 20

Com' ~~17/22/41~~

10% Overhead

12

1 32

125' 1" Copper tubing @ 22¢

27 50

1 1" C.x 3/4" I.S.& W.

2 50

2 1" C.Unions (3 parts) @ 1.25

2 50

1 hr. trucking @ 75

75

34 57

November 25, 1941

Deposited

45 00

Dec 30 1941

Refund

10 43

34 57

Partial  
Refund of balance  
17.00 received 1/14/47.

Labor

DATE \_\_\_\_\_

# TOWN OF LEXINGTON—BOARD OF PUBLIC WORKS

## WATER DIVISION

The undersigned applies for a supply of water at No. \_\_\_\_\_ St. and hereby agrees to comply with the rules and regulations as now, or at any future time, established by the Board of Selectmen.

Am't. of Estimate \$ \_\_\_\_\_


Owner \_\_\_\_\_

Am't. Paid \$ \_\_\_\_\_

Address \_\_\_\_\_

Builder \_\_\_\_\_

Sketch of Service Here

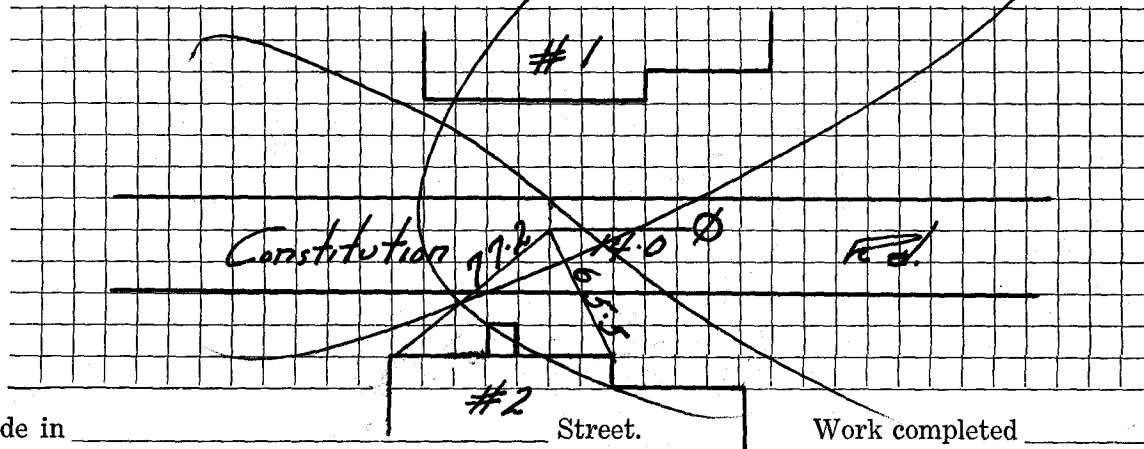

Connection made in \_\_\_\_\_

Street.

Work completed \_\_\_\_\_

19

Remarks: