

Name L. L. BARRY  
 Address 36 PAUL REVERE  
~~Oxford County~~ Road, Lexington

Service No. 2118  
~~30~~

# 1758

Location

Kind of Pipe

Size

Size of Main

~~Repair-Renewal~~ - New Service

Location

Date	Material	Amount	Total	Date	Amount
<i>Comm. 16. 6-20-33</i>	42' $\frac{3}{4}$ " Copper Pipe @ .12	5 04			
	1 S & W	2 75			
	Trucking	75	\$8 54	<i>May 13 1933 - Cash</i>	16 -
<i>5/15/33</i>	7 Hrs. Labor @ .55	3 85			
	2 " " @ .60	1 20	5 05		
	15% Overhead		76		
			14 35		
	Estimated cost, and				
	CHARGE		\$16 00		
	Labor				

Hidley Press, Inc., Lexington

DATE July 15, 1923

TOWN OF LEXINGTON—BOARD OF PUBLIC WORKS  
WATER DIVISION

The undersigned applies for a supply of water at No. Herbell St. and hereby agrees to comply with the rules and regulations as now, or at any future time, established by the Board of Selectmen.

Am't. of Estimate \$ 16.00

Owner L. L. Barry

Am't. Paid \$ 16.00


Address Old County Road

Builder (26')

Lexington

60/16.00/26  
120  
400  
760  
140

Sketch of Service Here

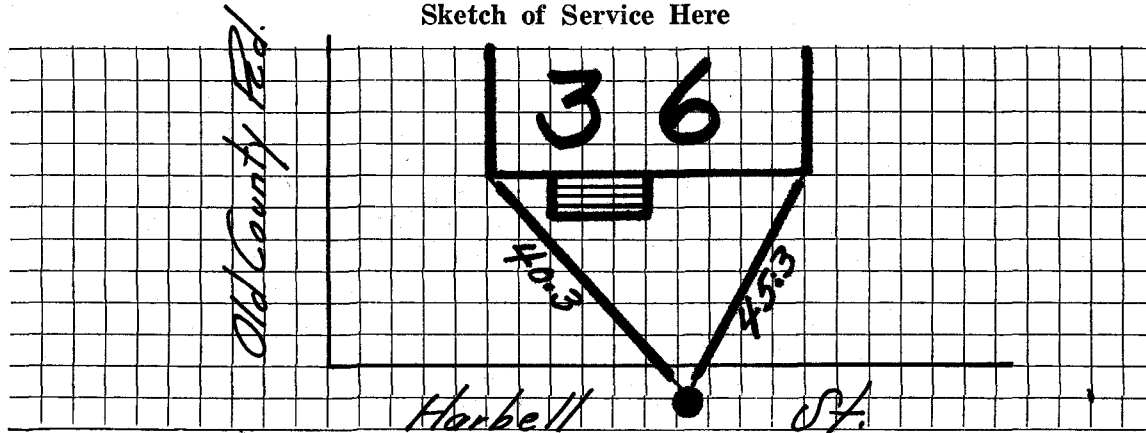

Connection made in \_\_\_\_\_ Street.

Work completed \_\_\_\_\_ 19

Remarks: