

WATER SERVICE RECORD

Name DeVries Const. Co.

Service No. 294 (1952)

Address 37 Paul Revere Rd.

# 4626

# 7281

Location Lexington

~~Renewal~~ New Service

COM.2-16-53

| Date   | Material                           | Amount | Total | Date                          | Amount     |
|--------|------------------------------------|--------|-------|-------------------------------|------------|
| 1/2/53 | Labor                              | 15 06  |       | 10-29-52 Deposited            | 65 00      |
|        | 10% overhead                       | 1 51   | 16 57 | 2-16-53 <del>Refund</del> *   | (1 04)     |
|        | 1/2" - 3/4" Copper Tubing @.34     |        | 15 64 |                               | NON CHARGE |
|        | 1-3/4" Cx 1/2" I.W.H. stop & Waste |        | 4 00  | 1/2/53 Labor                  | 15 06      |
|        | 2 Hrs. Town Shovel @5.00           |        | 10 00 | 21' - 3/4" Copper Tubing @.34 | 7 14       |
|        | 1 Hr. Trucking                     |        | 75    | 1-3/4" C. Corp-cock           | 4 33       |
|        | Patching 17 x 3                    |        | 17 00 | 1-3/4" Cx 3/4" C. Curb-cock   | 4 67       |
|        |                                    |        | 63 96 | 1 - Box & Rod                 | 3 90       |
|        |                                    |        |       | 1-1/2" offset Tail Piece      | 50         |
|        |                                    |        |       | 1-1/2" Straight Tail Piece    | 50         |
|        |                                    |        |       | 1 Hr. Town Shovel @5.00       | 5 00       |
|        |                                    |        |       | 1 Hr. Trucking                | 75         |
|        |                                    |        |       |                               | 41 85      |


\* 104 made payable to  
 Tu of Let to apply on  
 bal. due on w.s.c. 291 (1952)

DATE \_\_\_\_\_

TOWN OF LEXINGTON — BOARD OF PUBLIC WORKS

WATER DIVISION

Sketch of Service Here

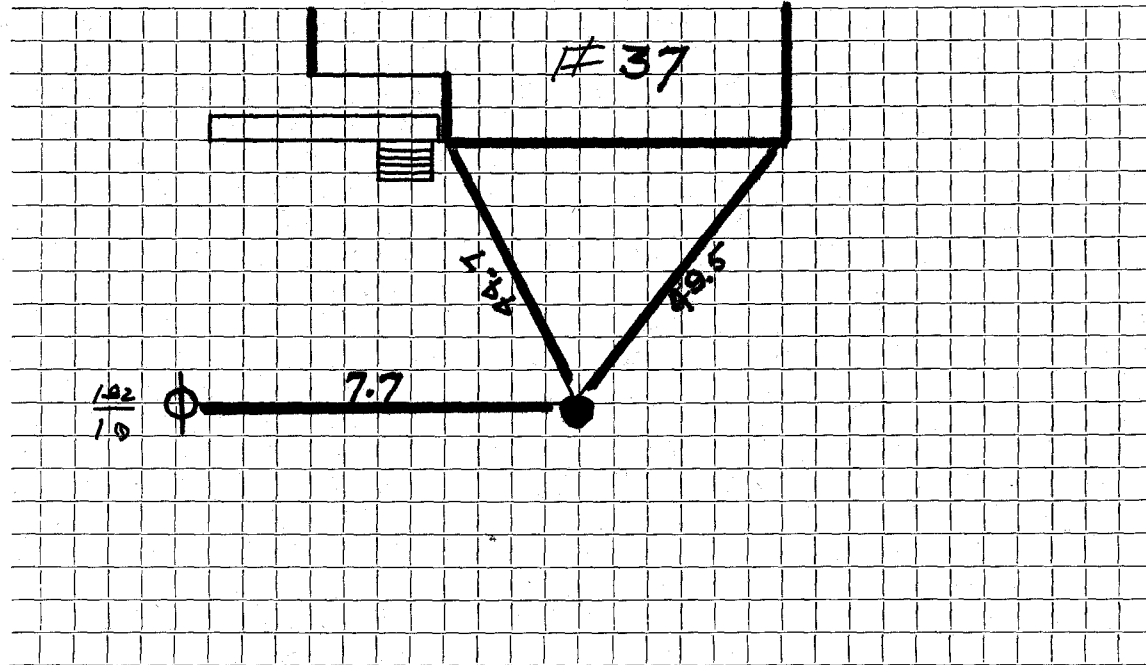

Connection made in ..... Street. Work completed .....

Remarks: .....  
.....  
.....