

Name James A. Graziano

Service No. 266

Address 38 Paul Revere Road

Lexington 73, Mass.

Location 38 Paul Revere Road

Kind of Pipe

Size

Size of Main

~~Repair - Repair~~ New Service

Com. 11-6-50

Location

Date	Material	Amount	Total	Date	Amount
Aug. 23, '50	Labor	1 50	1 50	<i>Aug 23 '50</i>	20 00
	10% Overhead		15		
	18' - 3/4" Copper Tubing @.275		4 95		17 64
	1 - 3/4"C x 1/2" I.W.H. S&W		3 29	Aug. 23, '50 Labor	3 50
	Littlefield Shovel 1 hr. @ 7.00		7 00		
	Trucking 1 hr. @.75		75	Service was in to curb	
			17 64		
	Labor				

Hadley Press, Inc., Lexington

# TOWN OF LEXINGTON—BOARD OF PUBLIC WORKS

## WATER DIVISION

The undersigned applies for a supply of water at No. \_\_\_\_\_ St. and hereby agrees to comply with the rules and regulations as now, or at any future time, established by the Board of Selectmen.

Am't. of Estimate \$ \_\_\_\_\_


Owner \_\_\_\_\_

Am't. Paid \$ \_\_\_\_\_

Address \_\_\_\_\_

Builder \_\_\_\_\_

Sketch of Service Here

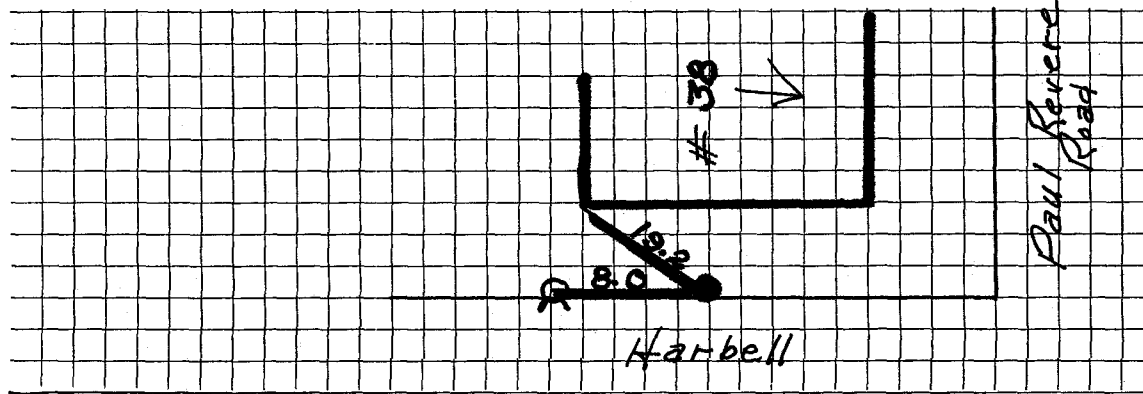

Connection made in \_\_\_\_\_ Street.

Work completed \_\_\_\_\_ 19

Remarks: