

WATER SERVICE RECORD

#5140

Name **Devries Construction Co.**

Service No. **295 (1952)**

Address **39 Paul Revere Road**

Location **Luxington**

~~Remarks~~ **New Service Com. 3/30/53**


Date	Material	Amount	Total	Date	Amount
3/13/53	Labor	3 14		10-29-52 Deposited	65 00
	10% overhead	31	3 45	3-30-53 Refunded	10 88
	80' - 3/4" copper tubing @ .34	.34	27 20		<u>NON CHARGE</u> 54 12
	1 - 3/4" C x 1/2 I.W.H. stop & waste		4 00	1/6/53 Labor	59 47
	1 - 3/4" c x 3/4C union		1 72	19' - 3/4" copper tubing @ .34	6 46
	1 hr. town shovel		5 00	1 - 3/4" C. corp-cock	4 33
	1 hr. trucking		75	1 - 3/4" C x 3/4" C. curb-cock	4 67
	patching 12 x 3		12 00	1 box and rod	3 90
			54 12	1 - 1/2 straight tail piece	50
				1 - 1/2 offset tail piece	50
				2 hrs. #36 compressor @ 2.75	5 50
	<b>TRENCH DUG BY OWNER</b>			2 hrs. town shovel @ 5.00	10 00
				1 hr. trucking	75
					<u>96 08</u>

DATE \_\_\_\_\_

TOWN OF LEXINGTON — BOARD OF PUBLIC WORKS

WATER DIVISION

Sketch of Service Here

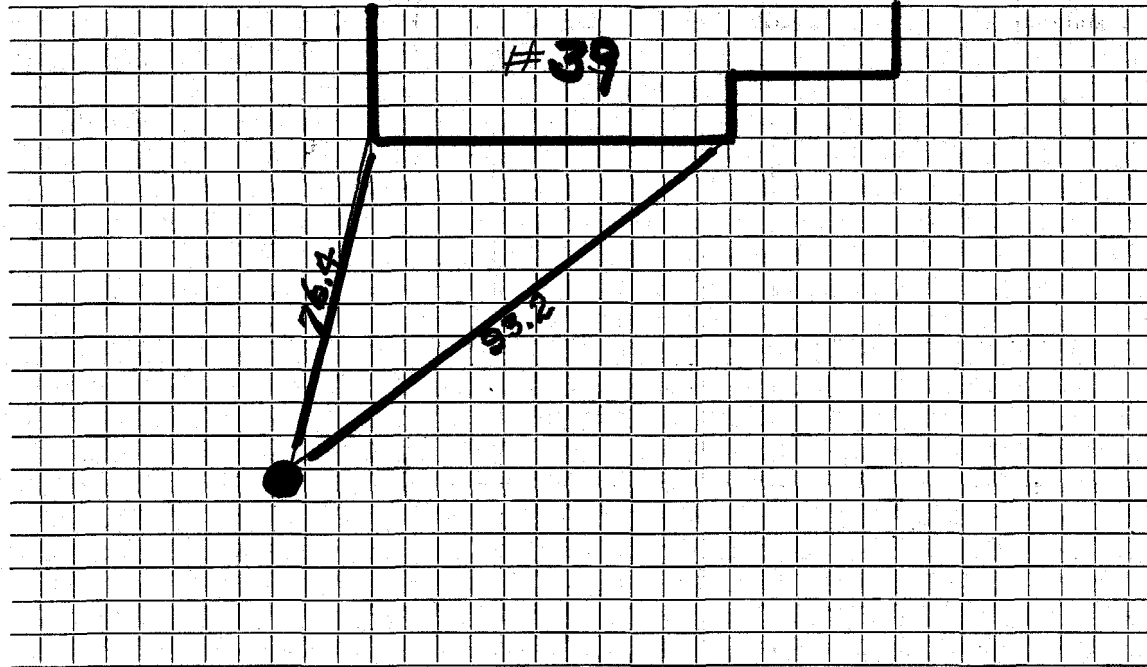

Connection made in ..... Street. Work completed .....

Remarks: .....

.....

.....