


TOWN OF LEXINGTON - BOARD OF PUBLIC WORKS
 WATER DIVISION

Date: 3/14/14

SKETCH OF SERVICE HERE

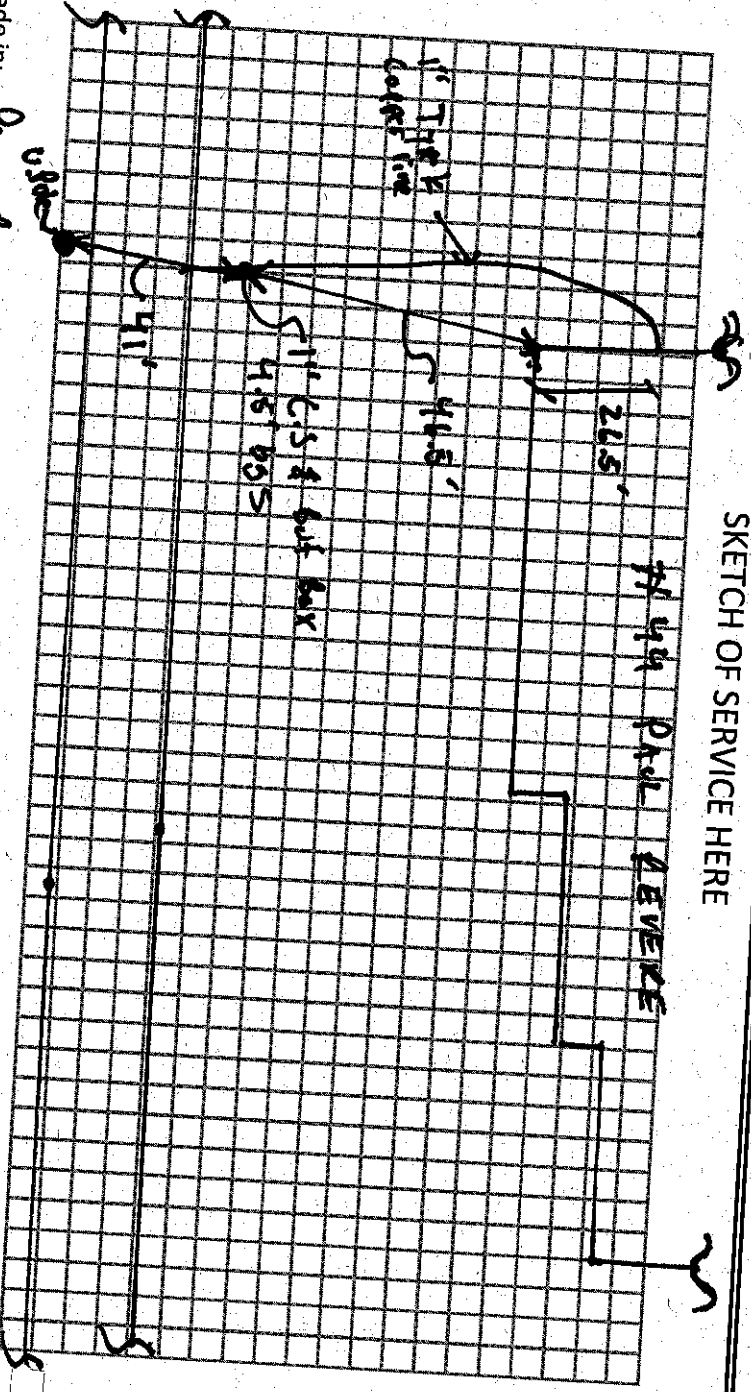

Connection made in: Five Levee

Street:

Work completed:

Remarks: * Existing Service lowered ~ 2' (IN Plan of New 1" C.S.)
to reduce risk of freeze up

Address 44 Paul Kense

Location

Repair - Renewal New Service

Date	Material	Amount	Total	Date		A
7/20/21	1" LAMB. BRASS					
	C. Stop					
	Buffalo Box					
	Type K 1" Copper					

WATER SERVICE RECORD

Name Charles H. S. King

Service No. 287

Address 141 Paul Revere Road

Location

~~Repair~~ New Service

Comm. 12-3-56


Date	Material	Amount	Total	Date	Amount
9/24/56	Labor	45 00		9-17-56	Deposit \$ 150 00
	10% overhead	4 50	49 50	12-10-56	Paid 13 13
	75' 3/4" copper tubing @.4850		36 38		<u>NON CHARGES</u> 163 13
	1 3/4" C Union 3 Part		2 27	Labor	19 40
	1 3/4" C x 1/2" I.W.H. stop&waste		4 96	32' 3/4" copper tubing @.4850	15 52
	2 hrs. trucking @ .75		1 50	1 3/4" Corp Cock	4 64
	6 hrs. Town Shovel @6.50		39 00	1 3/4" C Gurb Cock	5 94
	6 bags Rock Wool @1.42		8 52	1 Box & Rod	4 62
	21 x 3 Patch		21 00	1 1/2 Straight Tail Piece	50
			163 13	1 1/8 Offset Tail Piece	50
				1 hr. Town Shovel @6.50	6 50
				1 hr. Trucking @ .75	75
				9-8-58' Repair	58 37
				5' 3/4" Copper	
				1 3/4" C. Corp Cock	
				1 3/4" C. 3 Part Union	
				Bill sent 12-5-56	

DATE _____

TOWN OF LEXINGTON — BOARD OF PUBLIC WORKS

WATER DIVISION

Sketch of Service Here

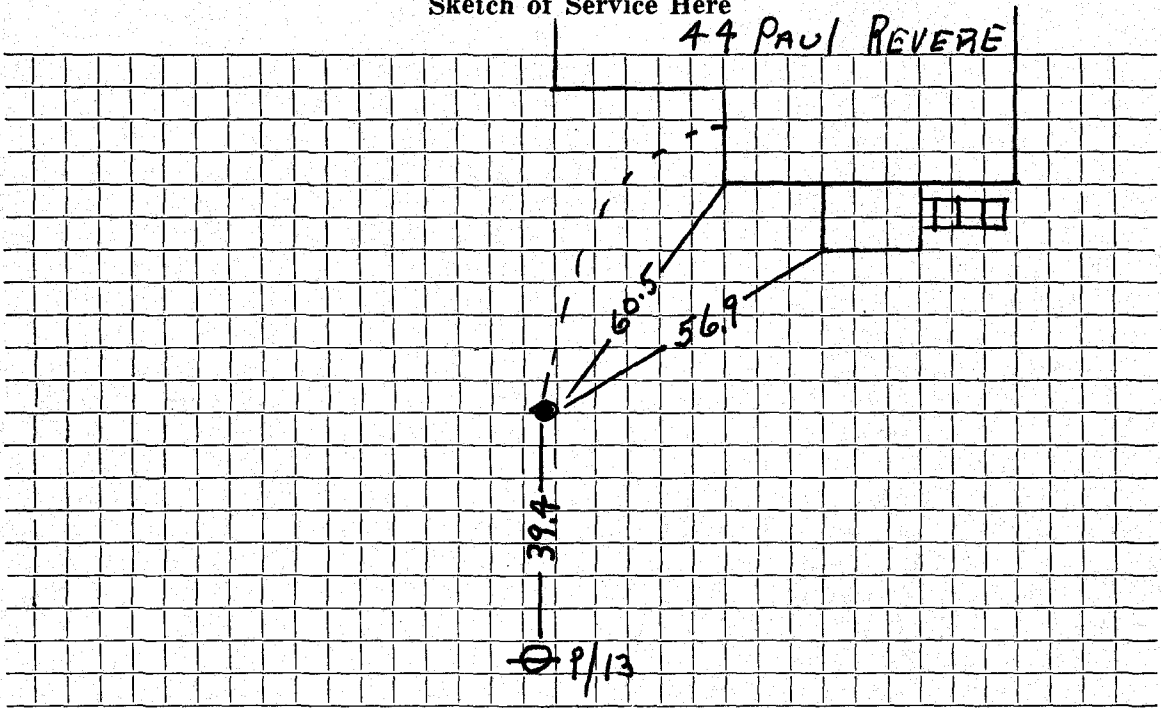

Connection made in Street. Work completed

Remarks:
.....
.....