

Name Martha Graziano

Service No. 73 104

Address 50 Paul Revere Road

4653

Lexington, Mass.

Location 50 Paul Revere Road

Kind of Pipe

Size

Size of Main

~~Removal of Old~~ New Service

Com. 6-14-49

Location

| Date | Material | Amount | Total | Date | Amount |
|-------------|---------------------------------|--------|-------|-------------|-------------------------------------|
| May 17, '49 | Labor | 3 80 | 3 80 | May 13 '49 | Deposited 35 00 |
| | 10% Overhead | | 38 | June 24 '49 | Refunded 26 3 |
| | 45' - 3/4" Copper Tubing @.27 | 12 15 | | | Non-Charge 27 37 |
| | 1 - 3/4" C x 1/2" I.W.H. S&W | 3 29 | | May 17, '49 | Labor 3 80 |
| | Littlefield Shovel 1 hr. @ 7.00 | 7 00 | | | 29' - 3/4" Copper Tubing @.27 7 83 |
| | Trucking 1 hr. @.75 | 75 | | | 1 - 3/4" C Corp-cock 3 15 |
| | | | 27 37 | | 1 - 3/4" C x 3/4" C Curb-cock 3 85 |
| | | | | | 1 - Box & Rod 3 95 |
| | | | | | 2 - 1/2" Offset Tail Pieces @.37 74 |
| | | | | | Littlefield Shovel hr. @7.00 7 00 |
| | | | | | Trucking 1 hr. @.75 75 |
| | | | | | <u>31 07</u> |
| | Labor | | | | |

TOWN OF LEXINGTON - BOARD OF PUBLIC WORKS

WATER DIVISION

The undersigned applies for a supply of water at No..... St. and hereby agrees to comply with the rules and regulations as now, or at any future time, established by the Board of Selectmen.

Am't of Estimate \$.....

Owner


Am't Paid \$.....

Address

Builder

.....

Sketch of Service Here

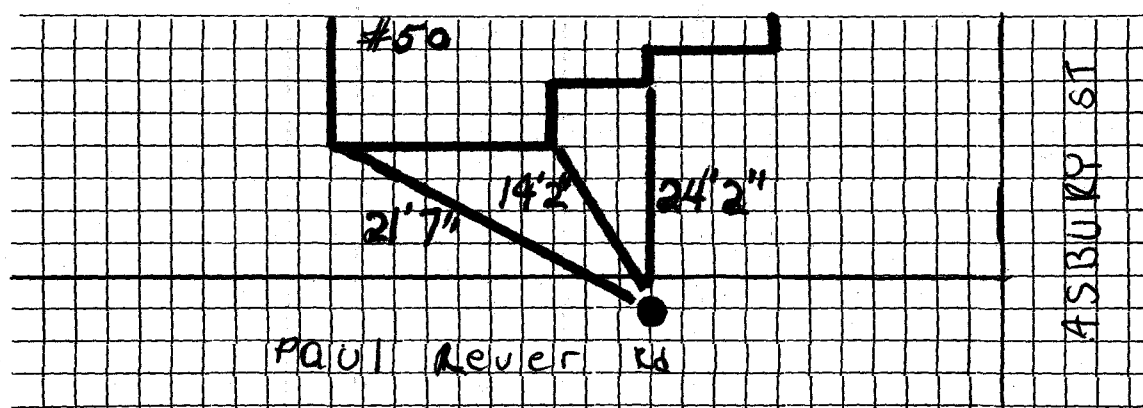

Connection made in Street.

Work completed19

Remarks: