

WATER SERVICE RECORD

Name

Service No.

Address

52 Paul Revere Road # 3067

Location

Lexington

~~Repair-Renewal~~

New Service


Date	Material	Amount	Total	Date	Amount
3-3-53	50' 3/4" Copper				
	1 3/4" C. X 1/2" I.W.H. Stop & Waste				
				5/23/52	NON CHARGE
					Labor 6 04
					12' - 3/4" Copper tubing @ .326 3 91
					1 - 3/4" C. Corp-cock 4 33
					1 - 3/4" C x 3/4" C. Curb-cock 4 67
					1 box and rod 4 68
					1 hr. Littlefield shovel 7 00
					1 hr. trucking 75
					31 38

DATE _____

TOWN OF LEXINGTON — BOARD OF PUBLIC WORKS

WATER DIVISION

Sketch of Service Here

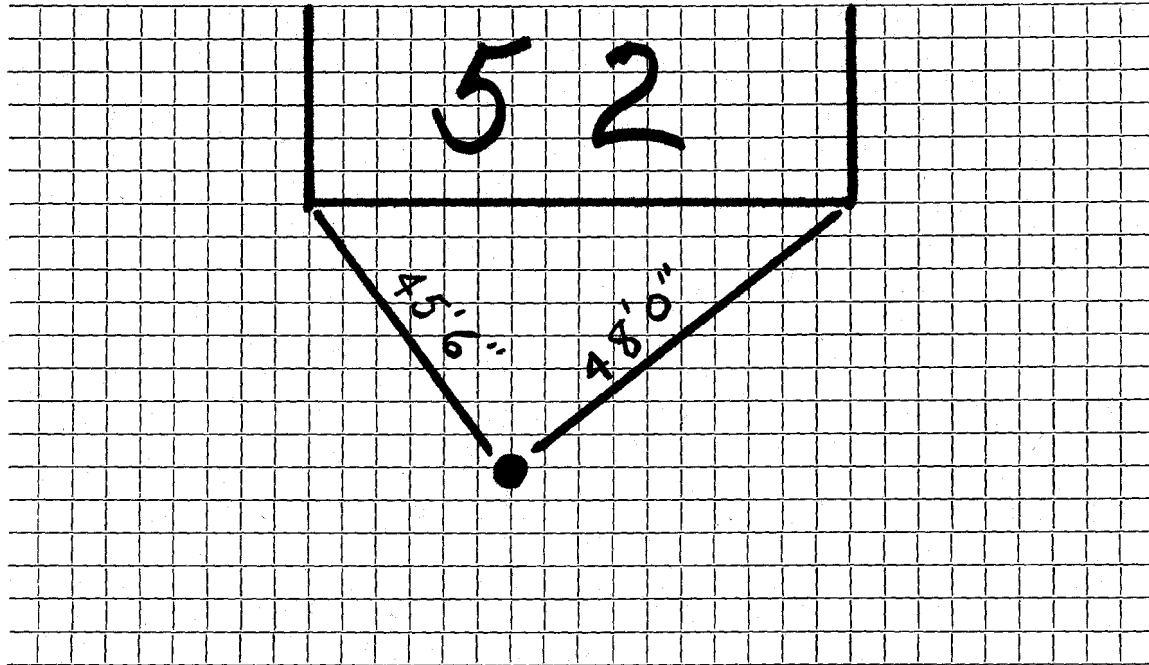

Connection made in Street. Work completed

Remarks:

.....

.....