

WATER SERVICE RECORD

Name Moore Homes, Inc.

Service No. 66

Address 53 Paul Revere Rd.

Location

JUN 20 1977

~~Repair Record~~ — New Service De License #2894


Date	Material	Amount	Total	Date	Amount	
12/14/76	labor	66. 32		12/13/76	Deposit	200. 00
	10%OH	6. 63	72. 95	6/20/77	Refund	32. 21
37'	1" copper @ .83		30. 71			167. 79
1	1" 3 part union		7. 77			
1	1" corp.		16. 69			
1	1" curb.		18. 67			
1	box and rod		13. 00			
½	hr. trucking @ 3.00		1. 50			
1	hr. shovel @ 6.50		6. 50			
			167. 79			
3/11/77	37' 1" Copper					

DATE _____

TOWN OF LEXINGTON — BOARD OF PUBLIC WORKS

WATER DIVISION

Sketch of Service Here

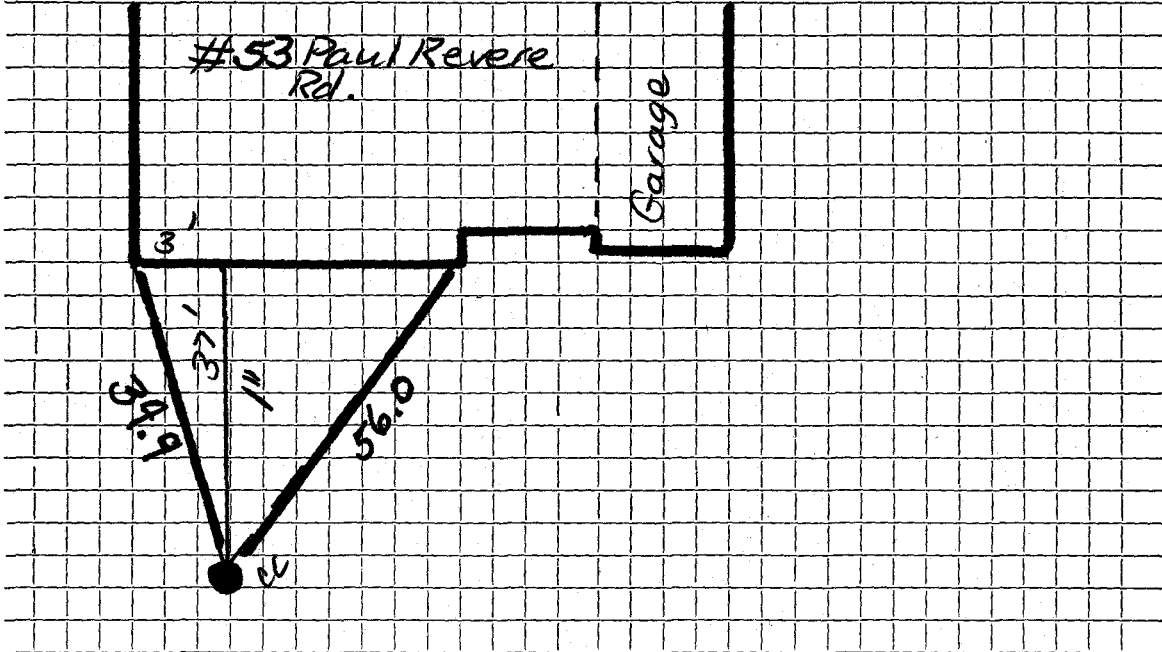

Connection made in Street. Work completed

Remarks:
.....
.....